



CERTIFIED LAND CORNER RESTORATION

Index No. **N-19**

State of Wisconsin }
 County of Oneida } ss,

I Philip T. Hansen, do hereby certify that on the 17th day of August, 1976, I found evidence of the quarter corner of Section 14 and 23 Township 37, North, Range 11, East, Fourth Principal Meridian, as described hereon; and that from this evidence I established a new monument and accessories as described hereon to perpetuate the original location of this corner.

Resident witnesses:
Glen Barker
Jim Clafflin
Herb Johnson

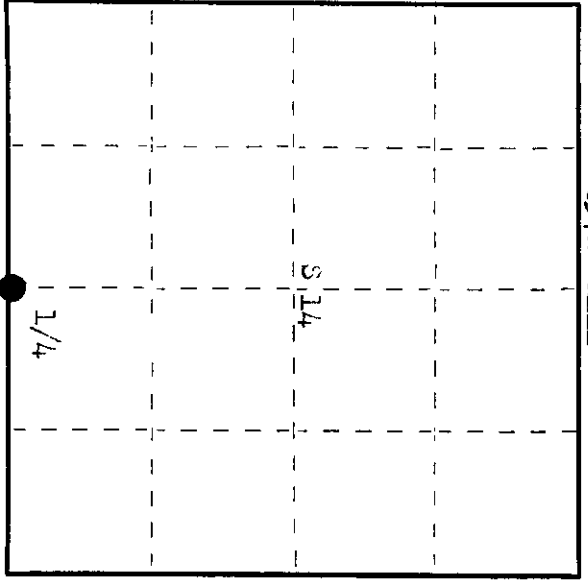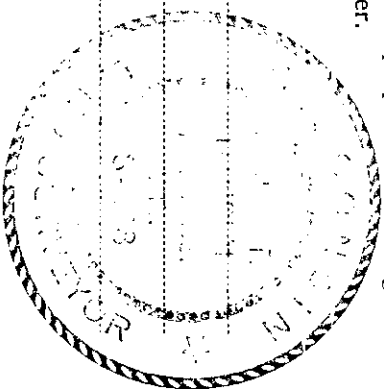

○ = Corner monument restored.

History of original corner establishment: Original corner established by John W. Dougherty, Deputy Surveyor, in 1859, from which Tamarack 6" bears N 10° W 9 links and Tamarack 6" bears S 10° W 14 links.

Corner recovered by J.J. Kelendy, Jagen Lumber & Cedar Company surveyor, in 1910. ran the section line east from the corner sec. 23, 40.67 chains to close out 11 links south of 1/4 post, + a 4" squared cedar post, original Tamarack N 10° W 9 links a stump and decayed. set new cedar post and marked DBT's - Tamarack 7" N 20° W 35 links, Tamarack 7" S 84° W 49 1/2 links. W.W. Waine recovered corner in 1935. recovered point of Kelendy's stake and recovered original Tamarack 6" N 10° W 9 links (log with marks). recovered Kelendy's DBT's Tamarack 8" N 20° W 34 1/2 links, Tamarack 5" S 82° W 49 links. set 2" iron pipe. Description of corner evidence found:

recovered waine's 2" iron pipe with brass cap stamped. 134
 recovered DBT - Tamarack 5" (6") S 25° W 34.5 links, scribed 1/4 DBT. 137
 Tamarack 7" S 82° W 49 links, now a 51 stub. 14
 Tamarack 7" S 20° W 24.5 links, found only piece of stump. 523

Also recovered a 6" squared cedar point 4' long buried in muck 2 links north of waine's iron pipe.
waine claims to have found the original point, which must have been Kelendy's.

Description of monument and accessories I established to perpetuate the original location of this corner. as the 2 1/2" iron pipe was in good condition, it was left in place.

Drove support stakes around it.
 monument projects 24" above ground.
DBT - Tamarack 8" S 60° W 44.4 links, scribed 1/4 DBT.
 Tamarack 6" S 10° W 16.7 links, scribed 1/4 DBT.
 monument and DBT's painted blue.

Dated at Waukegan, Wis., this 1st day of September, 1976

Signature Philip T. Hansen Title Registered Land Surveyor Registration No. 3-498
 (County Surveyor, Registered Land Surveyor, or other duly authorized official)

Office of Register of Deeds, County of Oneida.
 Instrument was filed in this office for record on the 29th day of September, 1976 at 2:30 o'clock P.M. I hereby certify that the within

By Terre Berge Kuehn (Register of Deeds)

By _____ Deputy

211148820