

CERTIFIED LAND CORNER RESTORATION

Index No. **N-18**



State of Wisconsin

County of Oneida } ss.

I Philip T. Hansen, do hereby certify that on the 17th day of August, 1976, I found evidence of the corner of section 14 and 23 Township 37 North, Range 11 East, Fourth Principal Meridian, as described hereon; and that from this evidence I established a new monument and accessories as described hereon to perpetuate the original location of this corner.

Resident witnesses:

Glen Barker
Jim Clafflin
Herb Emerson

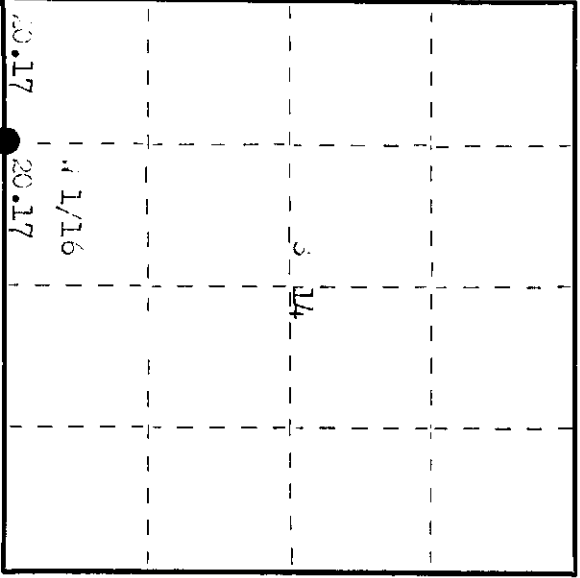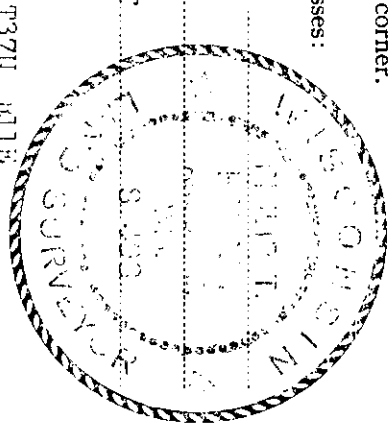

○ = Corner monument restored.

History of original corner establishment: Corner established by Verne and Uelma County Surveyor, in 1935. Ran a random line (Var. 30° 00' ±) from section corner 14, 15, 24, 25 40 34 chains and closed out 1.55 chains north of 1/4 corner. Set a 1/16 corner at 20.17 chains, 77 1/2 links south and marked 37's - spruce 12" x 15" x 19 links and cedar 5 1/2" x 24" x 30 links. Corner recovered by H.C. Lawrence, Registered Land Surveyor, in 1949. He ran east from the section corner 14, 15, 24, 25 (N 89° 10' ±) 20.23 chains, closed out 21 links south of mainline's 1/16. Corrected bearing N 89° 10' ±. Set new post in place of mainline's post. Marked 37's - spruce 12" x 15" x 18 1/2 links, Cedar 6" x 24" x 30 links, Balsam 12" x 4" x 35 1/2 links.

Description of corner evidence found: Recovered mainline's 5" cedar post, squared and scribed 1/8 x 1/32, with rock board around it. Also recovered Lawrence's 5" cedar post squared and scribed 5/16, x 1/16 323, bears east 1 link from mainline's. Recovered 37's (Mainline's) - spruce 12" x 15" x 18 1/2 links, now a cut off stump.

Cedar 6" x 24" x 30.3 links, scribed 1/8 x 3/16 - dead.
Balsam " 4" x 35.5 links, now decayed stump.
Maple 12" x 34" x 24.0 links, scribe marks visible.

Description of monument and accessories I established to perpetuate the original location of this corner. Replaced mainline's wood post with 1 1/2" OD iron pipe with brass cap stamped:

Monument projects 24" above ground. 3498
Replaced rock cairn around base of monument. 137 1/2 011
MBT - Cedar 6" x 76" x 40.1 links, scribed 1/16 x 1/16 " 1/16 3 1/4
Cedar 6" x 46" x 54.7 links, scribed 1/16 MBT. 5 23
Monument and 37's painted blue. 01-1-1970

Dated at Oneida, Wis., this 1st day of September, 1976

Signature: *Philip T. Hansen* Title: Registered Land Surveyor Registration No. 2498
(County Surveyor, Registered Land Surveyor, or other duly authorized official)

Office of Register of Deeds, County of Oneida. I hereby certify that the within instrument was filed in this office for record on the 29th day of September, 1976 at 2:30 o'clock P.M.

Donna Terrence Kuehn
(Register of Deeds)

By: Deputy

3711140030