

CERTIFIED LAND CORNER RESTORATION



L 19 Index No. L-19

State of Wisconsin

County of Oneida } ss.

I Philip T. Hansen, do hereby certify that on the 17th day of July, 1975, I found evidence of the C-1/4 corner of Section 14 Township 37 North, Range 11 East, Fourth Principal Meridian, as described hereon; and that from this evidence I established a new monument and accessories as described hereon to perpetuate the original location of this corner.

Resident witnesses.

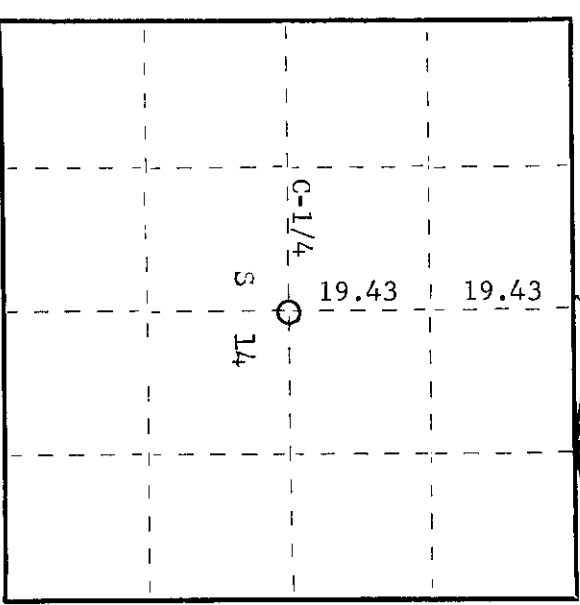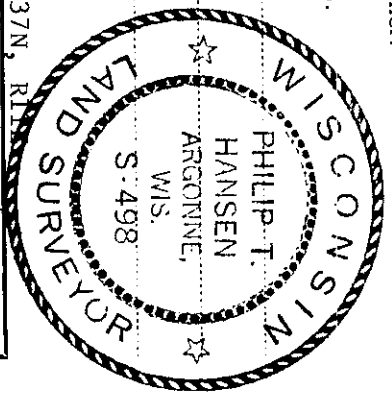

O = Corner monument restored.

History of original corner establishment:

Corner established by J.A. Melendy, Gagen Lbr. Co. Surveyor, in 1918. Set stake from which white pine stump 30", bears S48°E, 36 lks. and white pine stump 36", bears S21-1/2°W, 40 lks. Corner was destroyed when H.C. Lawrence looked for it in 1954. A burrow pit had been bulldozed at its site. He found one of the white pine stumps with scribe marks rolled out along the edge of the pit. Corner was restored by running the line south from N-1/4 Corner. He recovered Melendy's N C-1/16 Corner at 19.43 chains. Set C-1/4 Corner 4" cedar post at 38.86 chains and marked NBT's white pine 16", S58°E, 50 lks. and white pine 18", S84°W, 18 lks. Description of corner evidence found:
Recovered corner set by H.C. Lawrence in 1954, 4" cedar post squared and scribed C-1/4 S S14 C-1/4 S in fair condition.

Recovered OBT's White pine 16" (17"), S58°E, 50 lks., scribed C-1/4 S NBT.
White pine 18" (20"), S84°W, 118 lks.

Description of monument and accessories I established to perpetuate the original location of this corner.
Replaced 4" cedar post with 2-1/2" iron pipe w/brass cap stamped - S498
T37N, R11E
No additional BT's were made.

S14
C-1/4
CPI-1975

Dated at Rhineland, Wis., this 29th day of July, 1975.

Signature *Philip T. Hansen* Title Registered Land Surveyor
(County Surveyor, Registered Land Surveyor, or other duly authorized official)

Office of Register of Deeds, County of Oneida
Instrument was filed in his office for record on the 1st day of October, 1975 at 3:00 o'clock P.M.

Doris Savage Fuchs
(Register of Deeds)

By: Deputy