

CERTIFIED LAND CORNER RESTORATION



Index No. K-20

State of Wisconsin

County of Oneida } ss.

I Philip T. Hansen, do hereby certify that on the 28th day of October, 1975, I found evidence of the NE-1/16 corner of Section 14 Township 37 North, Range 11 East, Fourth Principal Meridian, as described hereon; and that from this evidence I established a new monument and accessories as described hereon to perpetuate the original location of this corner.

Resident witnesses:
Glen Barker
Jim Claflin

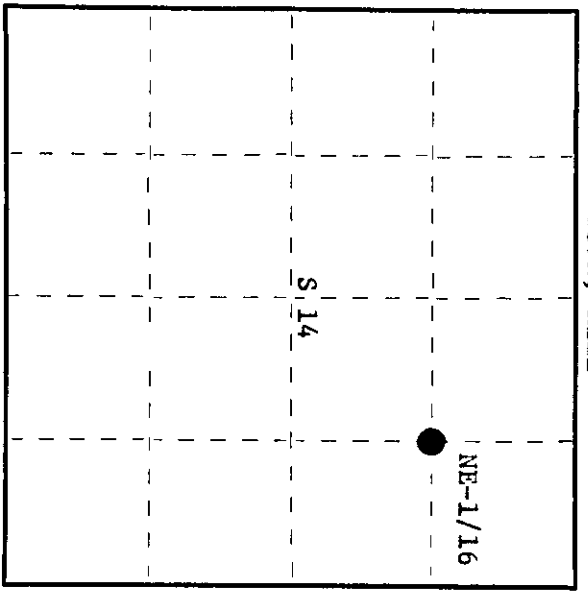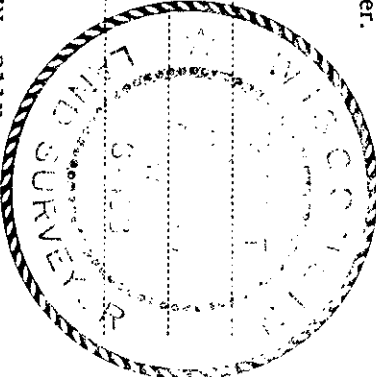

○ = Corner monument restored.

CERTIFIED LAND CORNER RESTORATION

History of original corner establishment:

Original corner established by J. Melendy, County Surveyor, in 1918 from which tamarack 8" bears N4°W, 23 links and pine 6" bears S58°E, 36 links. Corner recovered by H.C. Lawrence, Registered Land Surveyor, in 1954. Found old post and stump of tamarack N4°W and pine S58°E.

Description of corner evidence found:

Recovered Melendy's squared cedar post scribed 1/8S S14 in poor condition. Also recovered Lawrence's 4" cedar, squared and scribed NE-1/16 S14, NE-1/16 S14 in fair condition.

Recovered pine 6" (9") S58°E 36 links Scribed NE-1/16 BT

Tamarack stump N4W - now badly decayed.

Description of monument and accessories I established to perpetuate the original location of this corner.

Replaced wood post with 1" OD iron pipe with 2" brass cap stamped - S498 T37N R11E Post projects 18" above ground.

NBT - Cedar 5" N69°W 78.5 links Scribed 1/16 BT

Pipe and BT's painted blue. NE-1/16 S 14 CPT-1975

Dated at Rhinelander, Wis., this 7th day of October, 1975

Signature Philip T. Hansen Title Registered Land Surveyor Registration No. S-498
(County Surveyor, Registered Land Surveyor, or other duly authorized official)

Office of Register of Deeds, County of Oneida I hereby certify that the within instrument was filed in this office for record on the 9th day of November, 1976 at 3:30 o'clock P.M.

Louise Verage Ruckert
(Register of Deeds)

By: _____ Deputy

0102041123