



CERTIFIED LAND CORNER RESTORATION

Index No. N-17

State of Wisconsin } ss.
 County of Oneida }

I Philip T. Hansen, do hereby certify that on the 24th day of October, 1975, I found evidence of the Section corner of Sections 14, 15, 22, and 23 Township 37 North, Range 11 East, Fourth Principal Meridian, as described hereon; and that from this evidence I established a new monument and accessories as described hereon to perpetuate the original location of this corner.

Resident witnesses:
 Glen Barker
 Jim Clafflin

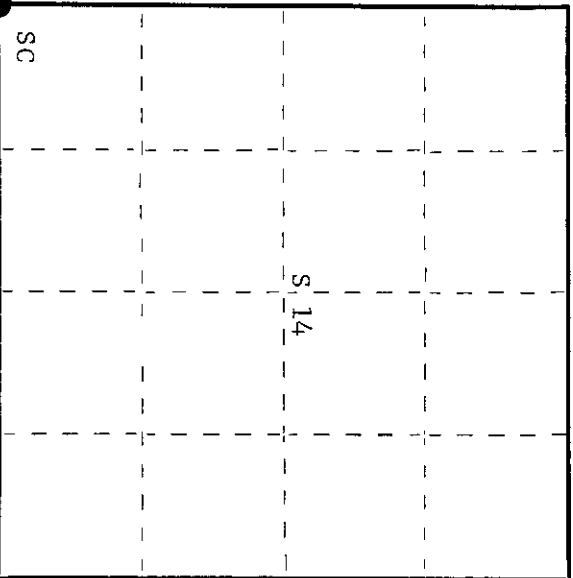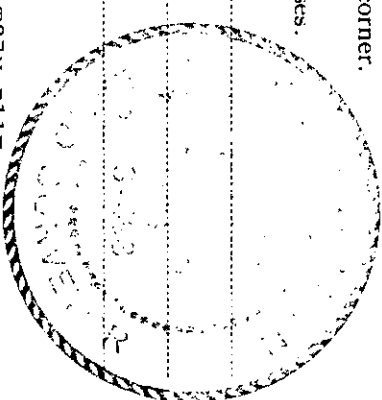

○ = Corner monument restored.

History of original corner establishment: Original corner established by Wm. E. Dougherty, Deputy Surveyor, in 1859 from which birch 9" bears N80°W, 41 links and maple 9" bears S65°E, 20 links. Corner recovered by J.J. Melendy, Gagen Lumber Company surveyor, in 1916. He found a large squared cedar post set for corner, origin unknown; original maple stub 5' high S66½°E, 18½ links; original birch N80°W, 41 links, a decayed stub. Set a new 5" cedar post and made NBT's: W. Pine stump 24" N15°W, 86½ links and W. Pine stump 48" S84°W, 71 links. Corner recovered by V.M. Maine, County Surveyor, in 1935. Set new scribed post which he later replaced with iron pipe. Claims to have found original stake, rotted off deep in muck. Recovered Melendy's white pine stumps for BT's. Marked NBT's: Spruce 9" N80°E, 42 links and Spruce 12" N38°W, 45 links. Also made X in 36" x 36" gray boulder S25°E, 16½ links. Corner recovered by H.C. Lawrence, Registered Land Surveyor, in 1949. Set new stake (cedar post). Description of further evidence found:

Recovered Maine's iron pipe with brass cap, post projects 24" above ground.
 Cap stamped - T37N R11E
 Also recovered Lawrence's 4" cedar post, squared and scribed S14, S15, S22, S23. The iron pipe was leaning and Lawrence's post had fallen down. S15 | S14
 Recovered OBT's: W. Pine stump 30" N15°W 86.5 links - badly decayed, S22 | S23
 Cedar 6" N18°W 41.5 links - now a cut-off stump, M.
 Cedar 5" N70°E 57.5 links - now a 7' stub, scribed S14 NBT,
 Boulder 36" x 36" S25°E 16.5 links.

Description of monument and accessories I established to perpetuate the original location of this corner. As the iron pipe was in good condition but leaning, it was reset in its original hole, now projects 18" above ground, and placed the wood post beside it.

NBT's: White Spruce 5" S80°W 4.5 links - scribed SC BT,
 White Spruce 7" N66°W 39.7 links - scribed SC BT.
 Pipe and BT's painted blue.

Dated at Rhinelander, Wis., this 6th day of November, 1975.
 Signature: *Philip T. Hansen* Title Registered Land Surveyor Registration No. S-498.
 (County Surveyor, Registered Land Surveyor, or other duly authorized official)

Office of Register of Deeds, County of Oneida
 Instrument was filed in this office for record on the 9th day of December, 1976
 at 1:30 o'clock P. M.

Doris Terage Huehn
 (Register of Deeds)

By: Deputy