

CERTIFIED LAND CORNER RESTORATION

Index No. N-15

State of Wisconsin



County of Oneida } ss.

I Philip L. Hansen, do hereby certify that on the 20th day of August, 1976, I found evidence of the quarter corner of section 15 and 22 Township 37, North, Range 11 East, Fourth Principal Meridian, as described hereon; and that from this evidence I established a new monument and accessories as described hereon to perpetuate the original location of this corner.

Resident witnesses:

Jim Claffin

Herb Lawsoner

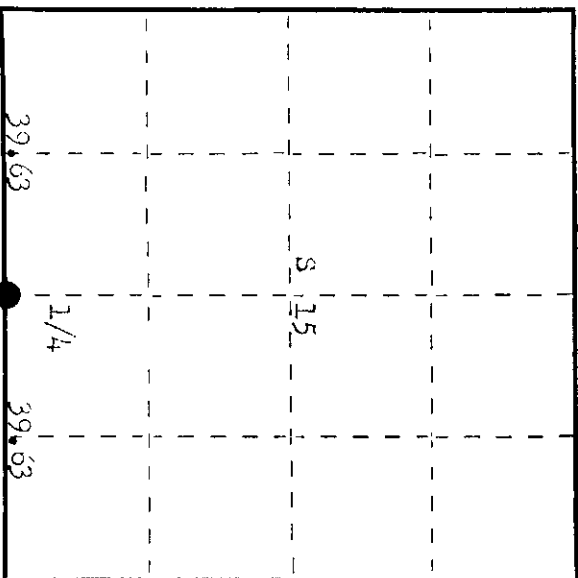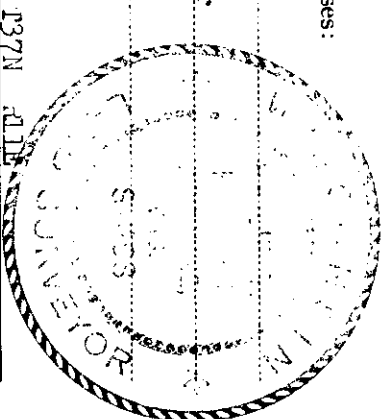

○ = Corner monument restored.

History of original corner establishment: Original corner established by Wm. W. Dougent, deputy surveyor, in 1859, from which line 20th bears N. 10° W, 22 links and 1st 3rd bears S. 25° W, 13 links.

Corner re-established by J. J. Ireland, Uagen lumber & cedar company surveyor, in 1917. ran random line west from SW corner 79.40 chains to close out 181 links south of SW corner. set 1/4 corner on corrected line and marked with 1" - fine stump 30" S 20° W 105 1/2 links, fine stump 48" S 47 1/2° W 146 links, popple 3" N 89° W 35 links. Corner recovered by V. ... Irvine in 1938. recovered Ireland's post and 5 1/2" - set 2 1/2" iron pipe. Corner recovered by H. W. Lawrence. set new post and marked with 1" - 1 1/2" iron 7" S 45° W 31 lks, maple 7" N 43° W 42 1/2 links, maple 7" S 28° W 102 1/2 links.

Description of corner evidence found:  
recovered 5" squared cedar post, scribbled 1/4 S 15, 1/4 W 22, in fair condition.  
Also recovered Wm's 1 1/2" iron pipe with brass cap, staked:  
monument projects 5" above ground.

137 111  
22 15  
4

000051113

Description of monument and accessories I established to perpetuate the original location of this corner.

as Wm's post was recovered in good condition, it was left in place.  
marked with 1" - 1 1/2" iron 8" S 66° W 23.8 links.

••• 5 1/2" iron 5" S 34° W 35.7 links.  
maple 6" S 82° W 89.4 links, all scribbled 1/4 SW.  
monument and 5 1/2" iron pipe, painted blue.

Dated at Oneida, Wis., this 2nd day of September, 1976.

Signature: Philip L. Hansen Title Registered Land Surveyor Registration No. 13771  
(County Surveyor, Registered Land Surveyor, or other duly authorized official)

Office of Register of Deeds, County of Oneida, I hereby certify that the within instrument was filed in this office for record on the 29th day of September, 1976 at 2:30 o'clock P. M.

Lorne Verage Kuehn  
(Register of Deeds)

By: \_\_\_\_\_ Deputy