

CERTIFIED LAND CORNER RESTORATION

117 Index No. M-17

State of Wisconsin

County of Oneida } ss.

I Philip T. Hansen, do hereby


certify that on the 17th day of July, 1975, I found

evidence of the S-1/16 Sections 14 and 15


corner of Township 37 North, Range 11 East, Fourth Principal Meridian,

as described hereon; and that from this evidence I established a new monument and accessories as described hereon to perpetuate the original location of this corner.

Resident witnesses:

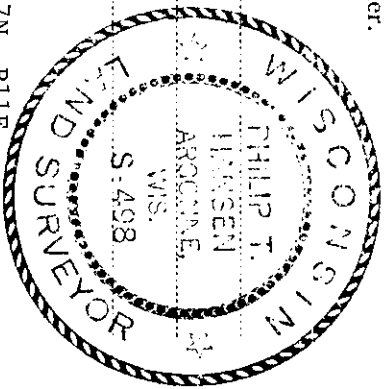

T37N, R11E

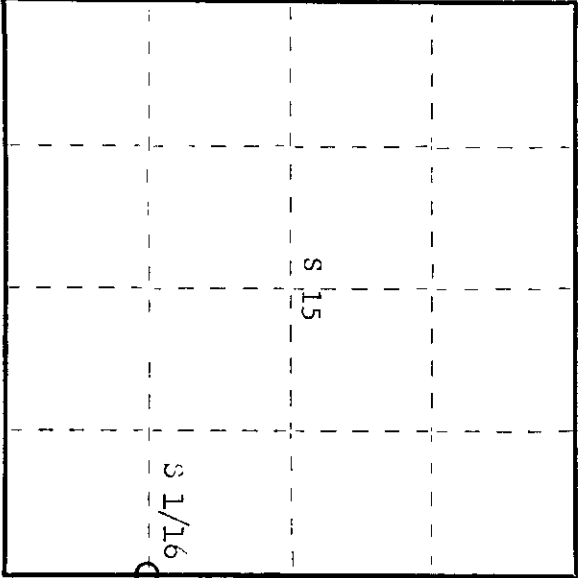

○ = Corner monument restored.

CERTIFIED LAND CORNER RESTORATION

History of original corner establishment

Corner established by J.A. Melendy, Gagen Lbr. Co. Surveyor. Set wood post and made BT's white pine stump 24", N75°W, 46 lks. and white pine 30", N80°E, 24 lks.

Corner recovered by H.C. Lawrence, Registered Land Surveyor. Set 5" cedar post from which cedar 10" bears N30°W, 24 lks. and cedar 11", bears S55°W, 38 lks. Spruce stump 14", bears N43°W, 21 lks.

Description of corner evidence found:

Recovered 4" cedar post, squared and scribed S-1/16 S14, S-1/16 S15 in poor condition.

Recovered OBT's Cedar 10", N30°W, 24 lks., scribing NBT visible.

Cedar 11" (13"), S55°W, 38 lks., scribing grown over.

Description of monument and accessories I established to perpetuate the original location of this corner.

Replaced 4" cedar post with 1-1/2" O.D. iron pipe w/2" brass cap stamped - S498

T37N, R11E

NBT Cedar 8", S72°E, 373 lks., scribed 1/16 BT.

S-1/16 S15 | S14

CPI-1975

Dated at Rhineland, Wis. this 29th day of July, 1975.

Signature: Philip T. Hansen, Registered Land Surveyor, No. S-498. (County Surveyor, Registered Land Surveyor, or other duly authorized official)

Office of Register of Deeds, County of Oneida. Instrument was filed in this office for record on the 1st day of October, 1975 at 3:00 o'clock P.M.

Doris George Fuchler (Register of Deeds)

By: Deputy

0001511137