

CERTIFIED LAND CORNER RESTORATION

Index No. L-17

State of Wisconsin

County of Oneida } ss.



I Philip T. Hansen, do hereby certify that on the 28th day of October, 1975, I found evidence of the Quarter corner of Sections 14 and 15 Township 37, North, Range 11 East, Fourth Principal Meridian,

as described hereon; and that from this evidence I established a new monument and accessories as described hereon to perpetuate the original location of this corner.

Resident witnesses:

Glen Barker

Jim Clafflin

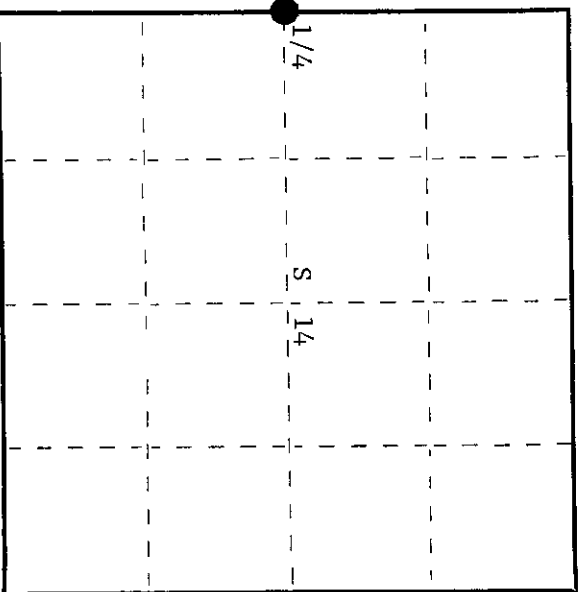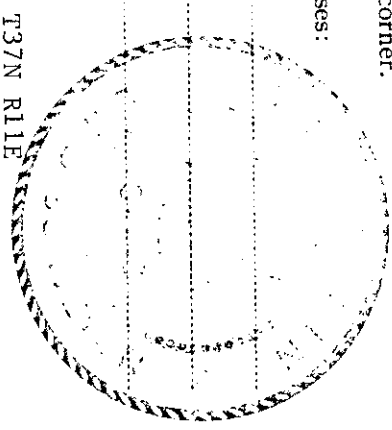

○ = Corner monument restored.

History of original corner establishment: Original corner established by Wm. E. Dougherty, Deputy Surveyor, in 1859 from which tamarack 5" bears N81°W, 9 links and spruce 6" bears S52°W, 24 links. Corner recovered by J.J. Melendy, County Surveyor, in 1918. Recovered original post and original tamarack marks plain, spruce S52°W, 24 links dead and decayed. Marked NBT's: Spruce 9" N5°W, 23-1/2 links; tamarack 6" S23°E, 6 links; spruce 8" N52°E, 31 links and tamarack 6" S60°W, 18 links. Corner recovered by V.M. Maine, County Surveyor. Set a 2-1/2" iron pipe with brass cap in place of wood post. Corner recovered by H.C. Lawrence, Registered Land Surveyor. Recovered iron pipe and two old posts. Recovered original BT: Tamarack 5" N81°W 9 links.

Description of corner evidence found:  
Recovered 2-1/2" iron pipe with brass cap, projects 24" above ground, stamped - T37 R11  
Also recovered an old squared cedar post beside it.  
Recovered OBT: Original tamarack 5" N81°W 9 links - now a 10' stub. 15-1/4-14

Description of monument and accessories I established to perpetuate the original location of this corner.  
As Maine's iron pipe was in excellent condition, it was left in place.  
NBT's: B. spruce 6" N66°W 33.3 links - scribed 1/4 BT,  
B. spruce 6" S71°W 10.5 links - scribed 1/4 BT.  
Pipe and BT's painted blue.

Dated at Rhinelander, Wis., this 7th day of November, 1975.

Signature: Philip T. Hansen Title Registered Land Surveyor Registration No. S-498  
County Surveyor, Registered Land Surveyor, or other duly authorized official

Office of Register of Deeds, County of Oneida I hereby certify that the within instrument was filed in this office for record on the 9th day of November, 1976 at 1:30 o'clock P. M.

Doris Heritage Fuchs  
(Register of Deeds)

By: \_\_\_\_\_ Deputy