

CERTIFIED LAND CORNER RESTORATION

N-13 Index No. N-13

State of Wisconsin } ss.
 County of Oneida


I Philip T. Hansen do hereby
 certify that on the 15th day
 of July 19 75 I found

evidence of the Section Corner
 corner of S15, S16, S21, S22


Township 37 North, Range
 11 East Fourth Principal Meridian,

as described hereon; and that from this evidence
 I established a new monument and accessories
 as described hereon to perpetuate the original
 location of this corner.

Resident witnesses

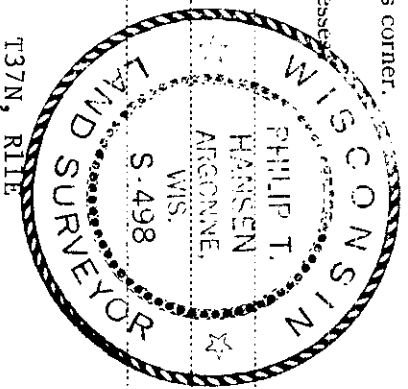

T37N, R11E

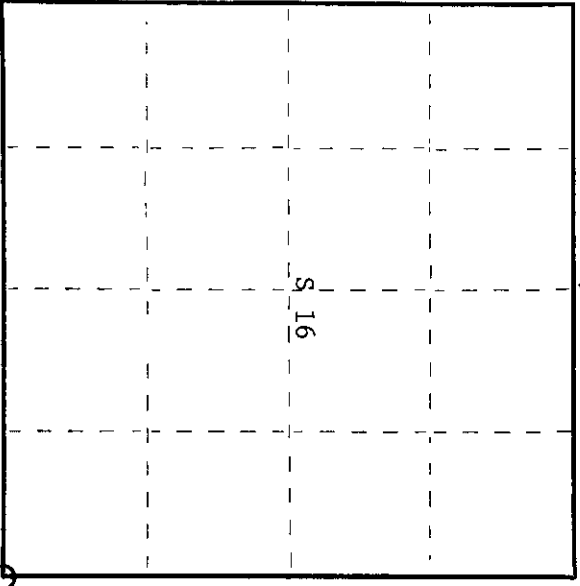

O = Corner monument restored.

History of original corner establishment:

Corner established by Wm. E. Dougherty, Gov't Deputy Surveyor, in 1859 from which fir 9", bears S15°W, 12 lks. and birch 10", bears N30°E, 15 lks. Corner restored by J.A. Melendy in 1916. He set a 4" post at the intersection of blazed lines east and west, north and south, and made NBT's - pine stump 48", N44°W, 139 lks.; hemlock 12", S19°E, 33 lks.; and cedar 9", N76°E, 38 lks.

Corner recovered by V.M. Maine in 1935. Set an iron pipe w/brass cap and marked NBT's - cedar 10", S53°W, 27-3/4 lks. and hemlock 12", N63-1/2E, 48 lks.

Corner restored by H.C. Lawrence, 1949. Recovered Melendy's post and Maine's iron pipe. Recovered Melendy's hem. BT 16", S16°E, 34 lks.; Maine's hem. stump 14", N59°E, 48 lks.; and Maine's cedar 10", S48°W, 31 lks. Set new cedar post and made NBT; Maple 18", S83°W, 89 lks.

Recovered 4" cedar post, squared and scribed S15, S16, S21, S22 in very poor condition, fallen down and moss covered.

Recovered 2-1/2" iron pipe w/brass cap, also lying down.

Recovered ORT's Hemlock 12" (15"), S19°E, 33 lks., scribed BT.
 Cedar 9", S55°W, 28 lks., now a 5' stub, scribed S21 BT.
 Sugar maple 18", S83°W, 89 lks., now a cutoff stump.
 No evidence of cedar 9", N76°E, 38 lks.

Description of monument and accessories I established to perpetuate the original location of this corner.

Replaced wooden post with 2-1/2" aluminum pipe w/cast cap stamped -

NBT - cedar 12", S15°W, 57 lks., scribed SC BT.

S498
 T37N, R11E
 S16 S15
 S21 S22
 1975

3711160000

Dated at Rhinelander Wis., this 29th day of July 19 75

Signature *Philip T. Hansen* Title Registered Land Surveyor Registration No. S-498
 (County Surveyor, Registered Land Surveyor, or other duly authorized official)

Office of Register of Deeds, County of Oneida
 instrument was filed in this office for record on the 1st day of October 19 75
 at 3:00 o'clock P.M.

Doris Verge Kuehn
 (Register of Deeds)

By Deputy