

CERTIFIED LAND CORNER RESTORATION



Index No. N-11

State of Wisconsin

County of Oneida } ss.

I Phillip T. Hansen, do hereby certify that on the 30th day of April, 1975, I found evidence of the Quarter corner of Sections 16 and 21 Township 37, North, Range 11 East, Fourth Principal Meridian, as described hereon; and that from this evidence I established a new monument and accessories as described hereon to perpetuate the original location of this corner.

Resident witnesses:

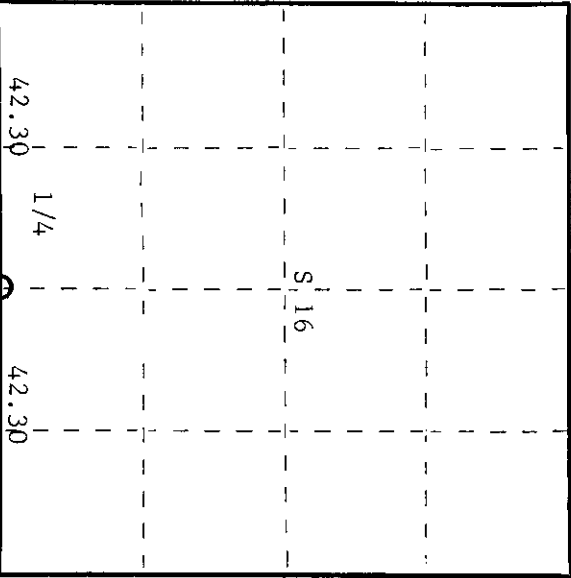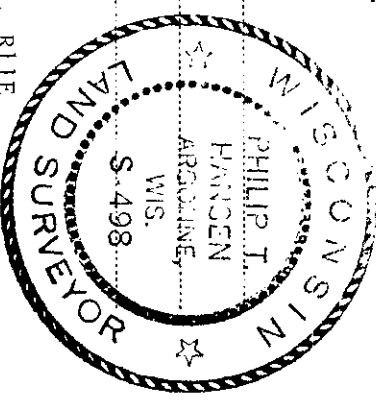

○ = Corner monument restored.

History of original corner establishment:

Original corner established by Wm. E. Dougherty, Gov. Deputy Surveyor, in 1859, from which hemlock 6" bears N31°W, 5 links and birch 10" bears N25°E, 15 links. Corner restored by V.M. Maine, County Surveyor. Set 2-1/2" iron pipe with brass cap stamped T37N R11E 1/4 Sec. 16/Sec. 21, from which cedar 6" bears N65°W, 65-1/2 links, soft maple 14" bears N28°W, 87-1/2 links.

Description of corner evidence found:

Recovered V.M. Maine's 2-1/2" iron pipe stamped T37N R11E S16 1/4 S21.
Recovered - Maple 14" N28°W 87.5 links - fallen down and badly decayed. No scribes visible.
Cedar 10" N65°W (N60°W) 65.5 links - scribing grown over.

Description of monument and accessories I established to perpetuate the original location of this corner.

Established NBT - Yellow birch 5" N47°W 39 links scribed 1/4 BT
Sugar maple 9" S74°E 23.8 links scribed 1/4 BT

Dated at Rhineland, Wis., this 19th day of May, 1975

Signature Phillip T. Hansen Title Registered Land Surveyor Registration No. S-498
(County Surveyor, Registered Land Surveyor, or other duly authorized official)

Office of Register of Deeds, County of Oneida
Instrument was filed in this office for record on the 1st day of October, 1975
at 3:00 o'clock P. M.

Terrie Terape Tucker
(Register of Deeds)

By: _____ Deputy

3711160020