

CERTIFIED LAND CORNER RESTORATION

Index No. **L-9**



State of Wisconsin

County of Oneida } ss.

I Phillip T. Hansen, do hereby certify that on the 7th day of September, 1976, I found evidence of the quarter corner of Section 16 and 17 Township 37 North, Range 11 East, Fourth Principal Meridian, as described hereon; and that from this evidence I established a new monument and accessories as described hereon to perpetuate the original location of this corner.

Resident witnesses:

Allen Barker  
Jim Clafflin  
Herb Essoner

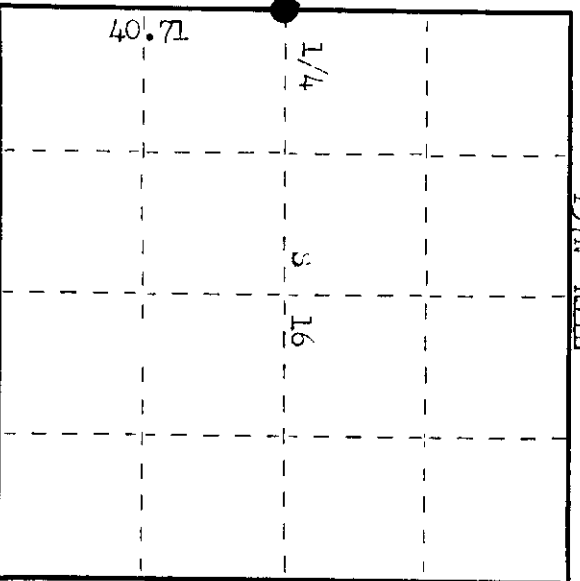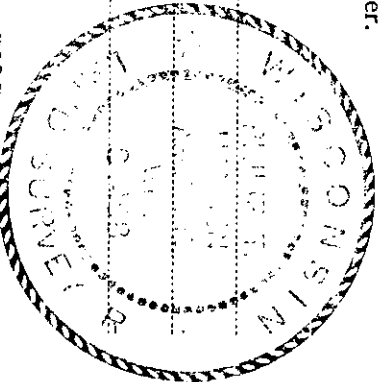

○ = Corner monument restored.

History of original corner establishment:

Original corner established by ... in 1859, iron which bore 9" bears N 24° W 9 links and spruce 3" bears N 80° E 10 links. H.C. Lawrence found an old post, origin unknown, for this corner in 1948 when he ran the line between section 16 and 17. Corner sets 40.71 chains N 29° 10' E of section corner. Set wood post and marked BTs - Norway pine 9" S 42° W 25 links and large boulder S 50° E 48 links.

Description of corner evidence found:

Recovered Lawrence's 4" tamarack post, squared and scribed 1/4 S 16, 1/4 S 17 in very poor condition. An old point, burnt cedar, was driven in ground at an angle beside Lawrence's post.  
Recovered BT - red pine 9" S 42° 30' W 25 links, scribed 1/4 S 17 BT. Now a 15" stub.  
Large boulder, S 50° E 25 links, bearing and distance to top of boulder.

Description of monument and accessories I established to perpetuate the original location of this corner.

Replaced tamarack post with 2" Bertelsen metal monument, stamped:  
monument projects 18" above ground.  
BTs - white pine 7" S 42° W 13.3 links, scribed 1/4 S 17.  
white pine 9" S 68° W 36.2 links, scribed 1/4 S 17.  
Corner sets off the north edge of bulwark ridge and on east edge of open swamp.  
monument and BTs painted blue.  
T37N R11E  
3498  
17110  
CPI-1976

Dated at Oneida, Wis., this 13th day of September, 1976.

Signature Phillip T. Hansen Title Registered Land Surveyor Registration No. 3-498  
County Surveyor, Registered Land Surveyor, or other duly authorized official

Office of Register of Deeds, County of Oneida.  
I hereby certify that the within instrument was filed in this office for record on the 9th day of September, 1976, at 10:30 o'clock A.M.

Lorne Berge Huchin  
(Register of Deeds)

By Deputy

371172000