

CERTIFIED LAND CORNER RESTORATION

Index No. L-7



State of Wisconsin

County of Oneida } ss.

I Philip T. Hansen, do hereby certify that on the 2nd day of August, 1979, I found evidence of the C 1/4 corner of Section 17 Township 37, North, Range 11 East, Fourth Principal Meridian, as described hereon; and that from this evidence I established a new monument and accessories as described hereon to perpetuate the original location of this corner.

Resident witnesses:

Glen Barker  
Jim Clafflin  
Herb Wagoner

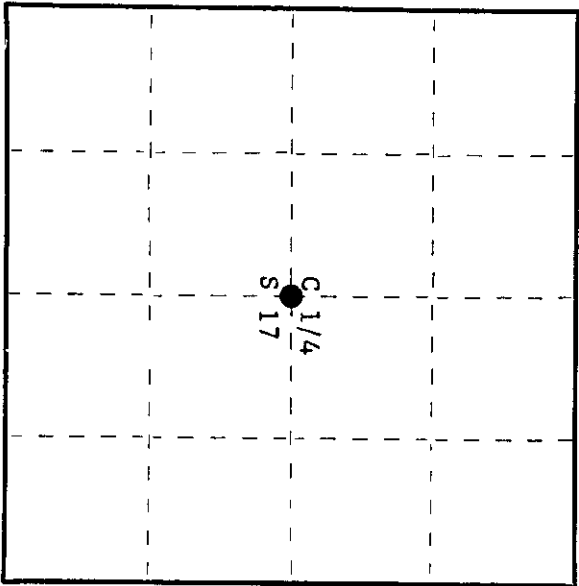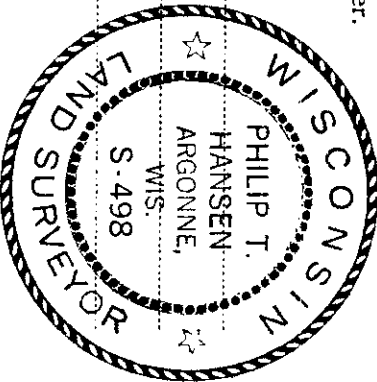

○ = Corner monument restored.

History of original corner establishment:

Corner established by H.C. Lawrence, Registered Land Surveyor, in 1948. He ran the N-S 1/4 line N 0° 30' E along old 1/4 line road at 40.90 chains. He found an old post, scribed C 1/4 corner 28 links west on the west bank of a water filled ditch. He believed this to be offset west of the center line as a witness corner. No records of who established this corner. The distance north to the N 1/4 corner was 40.60 chains. Set a new 4" squared cedar post, scribed C 1/4 S17 in center of old road. No records of any Br's established, all marsh grass and alders.

Description of corner evidence found:

Recovered H.C. Lawrence's squared cedar post, scribed C 1/4 - S17, standing but in very poor condition. Corner sets in the old abandoned N-S road, now flooded.

Description of monument and accessories I established to perpetuate the original location of this corner.

Replaced old cedar post with 2-1/2" Berntsen A-1 Federal Monument, projecting 8" above ground. Cap stamped:  
Drove two 1-1/2" iron pipes beside the monument to steady it and serve for location purposes.  
Set two - 1-1/2" x 5' iron pipes for witness markers.  
#1 - bears east 12 links  
#2 - bears south 15 links  
T37N R11E  
C 1/4 S-17  
S498-1979

Dated at Rhinelander, Wis., this 7th day of August, 1979

Signature Philip T. Hansen Title Registered Land Surveyor Registration No. S-498  
County Surveyor, Registered Land Surveyor, or other duly authorized official

Office of Register of Deeds, County of Oneida  
at 1:00 o'clock P. M. August 7 day of August, 1979  
I hereby certify that the within

Dorothy M. Knicker  
(Register of Deeds)

By Dorothy M. Knicker Deputy

0202111122