CERTIFIED LAND CORNER RESTORATION

Index No. K-9

State of Wisconsin
County of Oneida } ss.

I Philip T. Hansen, do hereby certify that on the 7th day of September, 19 76, I found evidence of the N 1/16 corner of Section 16 and 17 Township 37, North, Range 11 east, Fourth Principal Meridian, as described hereon; and that from this evidence I established a new monument and accessories as described hereon to perpetuate the original location of this corner.

Resident witnesses:

Glen Barker

Jim Claflin

Herb Wagoner

T37N R11E

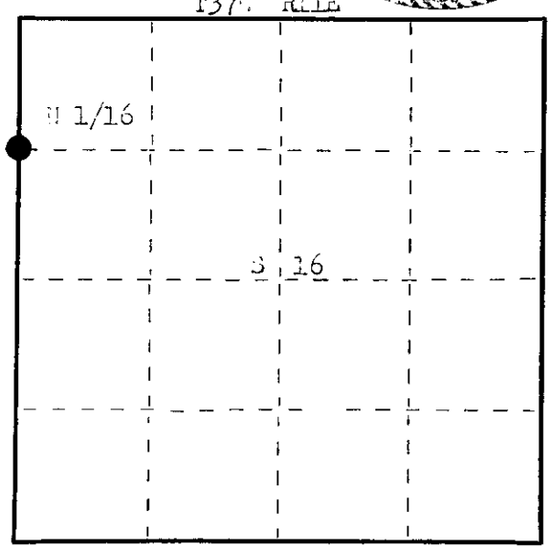

○ = Corner monument restored.

History of original corner establishment:

No records of establishment of this Corner.

Description of corner evidence found:

Recovered a 5" cedar post, squared and scribed N 1/16 S16, N 1/16 S17, laying on the ground covered with moss. This Corner believed to have been established by H.S. Lawrence, Registered Land Surveyor. Also found an old squared cedar post laying in muck beside it, at the point of old stake, recovered the old post hole.
Recovered OBT - Cedar 12" N 75° W 12.5 links, scribed N 1/16 S17, BT.
Y.Birch 9" N 44° W 4 links, scribed N 1/16 S17, a 6' stub.

Description of monument and accessories I established to perpetuate the original location of this corner.

Set 1½" iron pipe with 2" brass cap stamped:
Monument projects 18" above ground.
Drove support stakes in muck around pipe.
HBT - Cedar 8" S 24° W 50.5 links, scribed 1/16 BT.
Monument and BTs painted blue.

S498
T37N R11E
N 1/16 17 | 16
CPI-1976

Dated at Rhinelander, Wis., this 13th day of September, 1976.

Signature Philip T. Hansen Title Registered Land Surveyor Registration No. S-498
(County Surveyor, Registered Land Surveyor, or other duly authorized official)

Office of Register of Deeds, County of Oneida, I hereby certify that the within instrument was filed in this office for record on the 9th day of November, 19 76 at 10:30 o'clock A M.

Doris Virage Kuehn
(Register of Deeds)

By ..... Deputy

FORM 985 H. C. MILLER CO., MILWAUKEE

37111730000