

CERTIFIED LAND CORNER RESTORATION

N 4 Index No. N-4

State of Wisconsin }  
 County of Oneida } ss.

I Philip T. Hansen, do hereby

certify that on the 6th day

of May 19 75, I found

evidence of the E-1/16

corner of Sections 18 and 19

Township 37 North, Range


11 East, Fourth Principal Meridian,

as described hereon; and that from this evidence


I established a new monument and accessories

as described hereon to perpetuate the original

location of this corner.

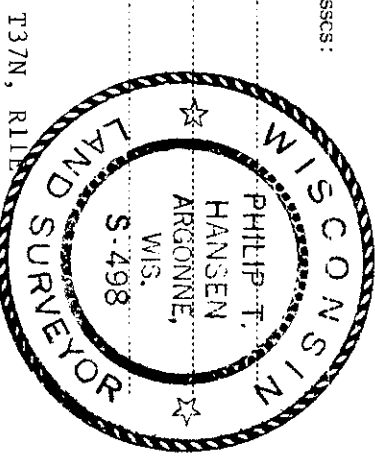

Resident witnesses:

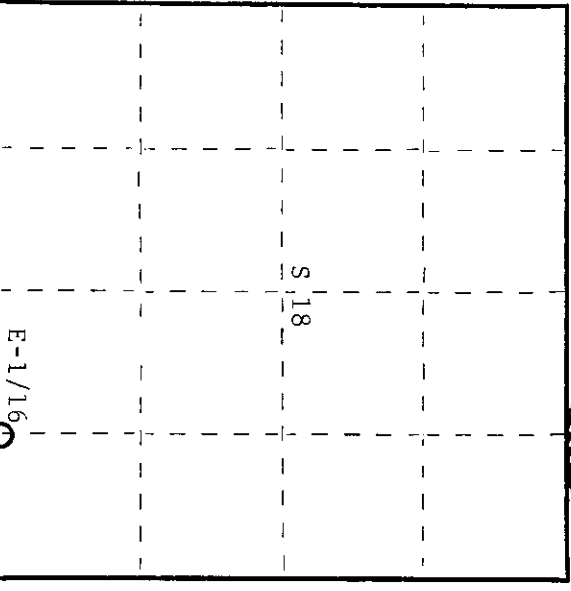

○ = Corner monument restored.

History of original corner establishment:

Corner established by H.C. Lawrence, Registered Land Surveyor, during his retracement survey in 1951. Set 4" oak post. Set equidistant between Section corner and quarter corner.

Set BT's - White pine stump	48"	N77°E	62 links
Oak cluster (3)	8"	N55°E	34 links
White pine stump	40"	S49°E	85 links

Description of corner evidence found:

Recovered 4" oak post, squared and scribed S19 E-1/16; S18 E-1/16 in poor condition. Also a 1-1/2" iron pipe set beside it.

Recovered red oak BT 15" N61°E 34.4 links, scribed S18 BT.

Description of monument and accessories I established to perpetuate the original location of this corner.

Replaced 4" oak post with 1-1/2" O.D. iron pipe with 2" brass cap stamped -

NBT - Sugar maple 8" S63°W 21.4 links S498 T37N, R11E

Poster on west side of road 2.43 west of E-1/16 corner

E-1/16 S118 S119 CPT-1975

Dated at Rhineland, Wis., this 2nd day of June, 19 75

Signature *Philip T. Hansen* Title Registered Land Surveyor Registration No. S-498  
 (County Surveyor, Registered Land Surveyor, or other duly authorized official)

Office of Register of Deeds, County of Oneida  
 Instrument was filed in this office for record on the 1st day of October 19 75  
 at 3:00 o'clock P.M.

*Doris Therese Fischer*  
 (Register of Deeds)

By Deputy

3711180010