

CERTIFIED LAND CORNER RESTORATION



M-5  
Index No. M-5

State of Wisconsin

County of Oneida } ss.

I Phillip T. Hansen, do hereby certify that on the 1st day of May, 1975, I found evidence of the S-1/16 corner of Sections 17 and 18 Township 37 North, Range 11 East, Fourth Principal Meridian, as described hereon; and that from this evidence I established a new monument and accessories as described hereon to perpetuate the original location of this corner.

Resident witnesses:

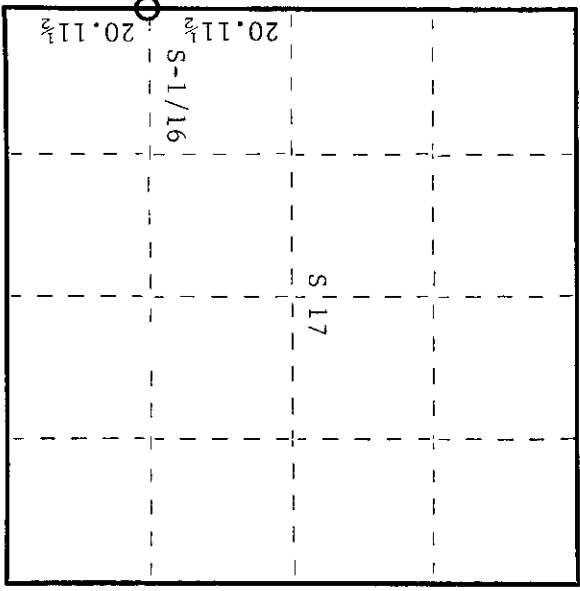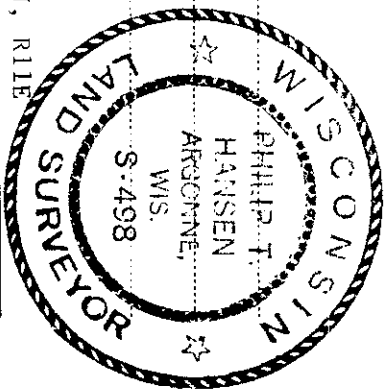

○ = Corner monument restored.

History of original corner establishment:

Corner established by H.C. Lawrence, Registered Land Surveyor, during retracement survey in 1949. From restored 1/4 corner (this was original corner; recovered original sugar BT, down but chopped away overgrowth to reveal scribe marks). He ran S4035' west mag. 40.23 chains to a point 4.25 west of Section corners 17, 18, 19, and 20. Corrected true line S1027'E. Found old S-1/16 corner at 20.11-1-1/2 chains, 2.12 chains east at right angles. Established a white pine stump 36" N129E 20 links. There was evidence of old scribe marks on this stump. Set new post - tamarack 5".

Description of corner evidence found:

Recovered 5" tamarack post, squared and scribed S17 S-1/16; S18 S-1/16 in poor condition. Also recovered a 1-1/2" pipe set up beside point of wooden post.

No evidence of old BT's visible.

Description of monument and accessories I established to perpetuate the original location of this corner.

Replaced wooden post with 1-1/2" O.D. iron pipe with brass cap stamped -

Established NBT's - White birch	11"	N90W	27.2 links	S498
Sugar maple	6"	S77°E	53 links, scribed 1/16 BT	T37N, R11E
			S-1/16	S18/S17

CPT-1975

Dated at Rhineland, Wis., this 23rd day of May, 1975

Signature *Phillip T. Hansen* Title Registered Land Surveyor Registration No. S-498  
(County Surveyor, Registered Land Surveyor, or other duly authorized official)

Office of Registrar of Deeds, County of Oneida  
Instrument was filed in his office for record on the 1st day of October, 1975  
at 3:00 o'clock P.M.

*Dennis George Tuelke*  
(Registrar of Deeds)

By \_\_\_\_\_ Deputy

3711181000