



CERTIFIED LAND CORNER RESTORATION

24 Index No. L-4

State of Wisconsin }  
County of Oneida } ss.

I, Philip T. Hansen, do hereby certify that on the 18th day of June 1975, I found evidence of the EC-1/16 corner of Section 18 Township 37 North, Range 11 East, Fourth Principal Meridian, as described hereon; and that from this evidence I established a new monument and accessories as described hereon to perpetuate the original location of this corner.

Resident witnesses:

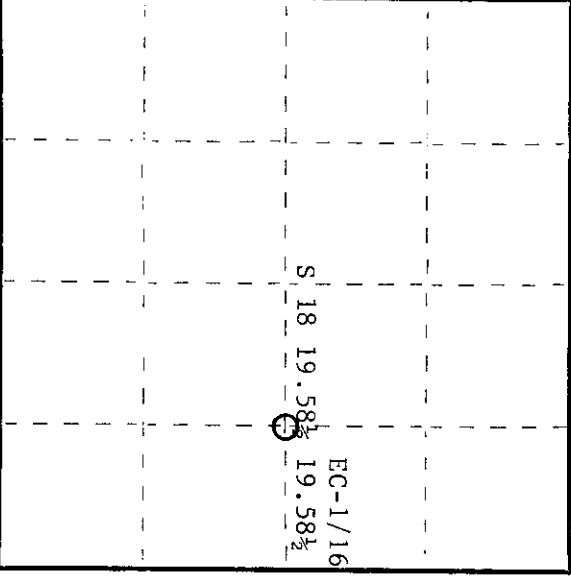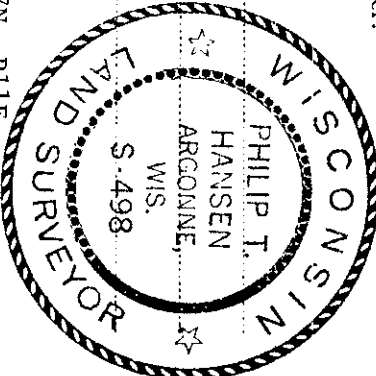

History of original corner establishment:  
Corner established by H.C. Lawrence, Registered Land Surveyor, in 1947. He ran a random line from the C-1/4 corner, N88°00'E, a distance of 39.17 chains, to intersect the East line 1.80 chains North of 1/4 corner between Sections 17 and 18 at right angles. Corrected bearing of line S89°22'E. Set a 5" cedar post 90 links South at right angles from 19.58 1/2 chains from which a hemlock 16" bears N70°W, 42 links and hemlock 20" bears S70°W, 50 links. A ten-ton boulder, 8' long 3' high and 4' wide, bears S40°W, 29 links.

Description of corner evidence found:  
Recovered 5" cedar post, squared and scribed EC-1/16 S18, EC-1/16 S18, in poor condition.  
The corner sets on the East edge of highline right-of-way.  
Recovered OBT's - Hemlock 16" N70°W 42 links now a cut-off 4' stub scribed EC-1/16 BT  
Hemlock 20" S70°W 50 links removed when clearing highline  
Boulder S40°W 29 links measured to face of boulder

Description of monument and accessories I established to perpetuate the original location of this corner.  
Replaced 5" cedar post with 1 1/2" OD iron pipe with 2" brass cap stamped -

NBT's - White birch 6"	S88°E	41.5 links	scribed 1/16 BT	S498
Red maple 5"	N46°E	72.4 links	scribed 1/16 BT	T37N, R11E
				EC-1/16 S 1/18

CPI-1975

Dated at Rhinelander, Wis., this 11th day of July, 1975.

Signature *Philip T. Hansen* Title Registered Land Surveyor Registration No. S-498  
(County Surveyor, Registered Land Surveyor, or other duly authorized official)

Office of Register of Deeds, County of Oneida  
Instrument was filed in this office for record on the 1st day of October 1975  
at 3:00 o'clock P.M.

*Doris Savage Kuehn*  
(Register of Deeds)

By: Deputy