


CERTIFIED LAND CORNER RESTORATION

Index No. L-3


43

State of Wisconsin }  
County of Oneida } ss.

I Philip T. Hansen do hereby certify that on the 18th day of June, 1975, I found evidence of the C&S corner of Section 18 Township 37 North, Range 11 East, Fourth Principal Meridian, as described hereon; and that from this evidence I established a new monument and accessories as described hereon to perpetuate the original location of this corner.

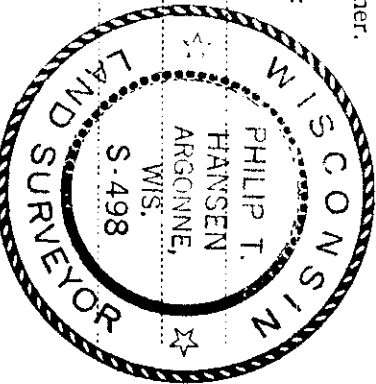

Resident witnesses:

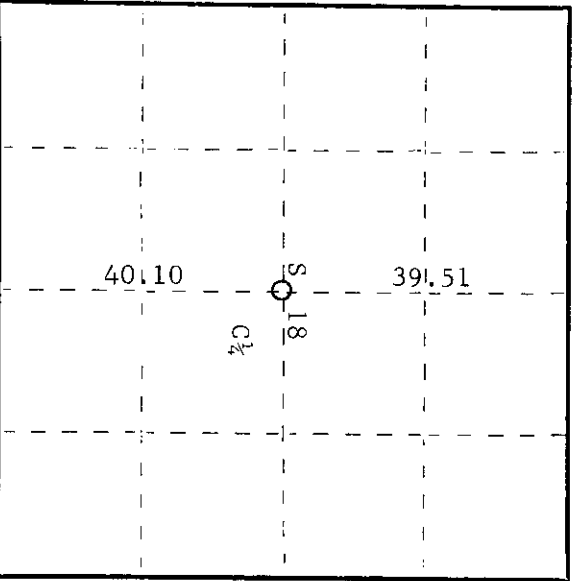

○ = Corner monument restored.

History of original corner establishment:

Corner established by D.H. Vaughan, County Surveyor, in 1898, from which white pine 17" bears S180E 18½ links; white pine 12" bears N400W 70 links. Corner recovered by H.C. Lawrence, Registered Land Surveyor, in 1947, during his retrace-ment survey. Recovered stumps of both of Vaughan's pine BT's and also dug out the point of his old stake. He rescribed Vaughan's white pine stump S180E and set new Norway pine post. Made NBT's - burnt white pine stump N320E 25 links; Norway pine tree 3" S550E 62 links.

Description of corner evidence found:

Recovered 4" post, squared and scribed C&S S18, C&S S18. Also a 4" pine post, square, lying on the ground, covered with moss.  
Recovered - white pine stump S80E 18½ links, badly decayed.  
White pine stump N320E 25 links, scribed C&S BT.  
Red pine 3" (9") S550E 62 links.  
Red pine 7" (8") N250E 22 links, scribed C&S BT.

Description of monument and accessories I established to perpetuate the original location of this corner.

Replaced wooden post with 2½" iron pipe with brass cap stamped -

No new BT's marked.

S498

T37N R11E  
S 18  
C&S

GPI-1975

Dated at Rhinelander, Wis., this 10th day of July, 19 75.

Signature Philip T. Hansen Title Registered Land Surveyor Registration No. S-498  
County Surveyor, Registered Land Surveyor, or other duly authorized official.

Office of Registrar of Deeds, County of Oneida  
Instrument was filed in this office for record on the 10th day of October 1975  
at 3:00 o'clock P. M.

Doris Verge Truck  
(Registrar of Deeds)

By: \_\_\_\_\_ Deputy