

CERTIFIED LAND CORNER RESTORATION

Index No. L-2
12



State of Wisconsin

County of Oneida } ss.

I, Philip T. Hansen, do hereby certify that on the 18th day of June, 1975, I found evidence of the WC-1/16 corner of Section 18 Township 37N, North, Range 11 East, Fourth Principal Meridian,

as described hereon; and that from this evidence I established a new monument and accessories as described hereon to perpetuate the original location of this corner.

Resident witnesses:

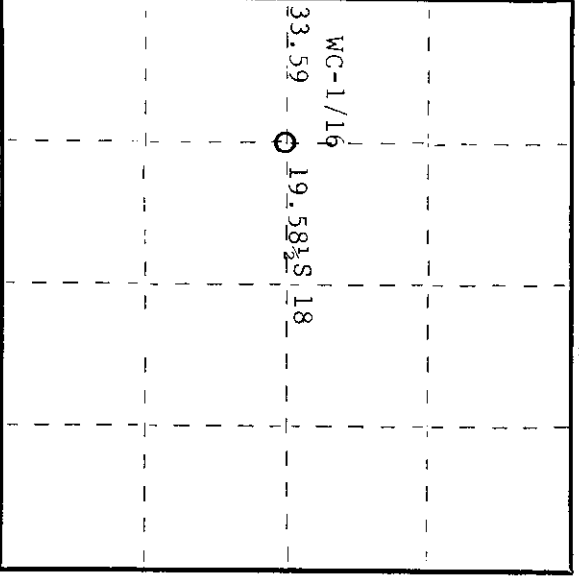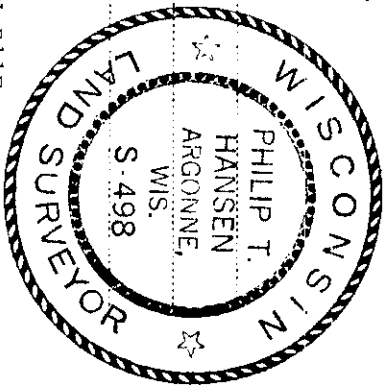

○ = Corner monument restored.

History of original corner establishment:

Corner established by H.C. Lawrence, Registered Land Surveyor, in 1947, during his retracement and subdivision survey. From established $C\frac{1}{2}$ corner, he ran random line west 52.97 chains to intersect Vaughan's $\frac{1}{2}$ post at 52.97. He set WC-1/16 corner at 19.58 $\frac{1}{2}$ west of $C\frac{1}{2}$ corner and 33.59 chains east of $W\frac{1}{2}$ corner, from which aspen 9" bears S120 $^{\circ}$ W 24 $\frac{1}{2}$ links, and aspen 9" bears N63 $^{\circ}$ W 26 links.

Description of corner evidence found:

Recovered 4" oak post, squared and scribed WC-1/16 S18, WC-1/16, in fair condition.
Recovered ORT's - aspen 9" N63 $^{\circ}$ W 26 links Blown over. Scribed WC-1/16 BT. Aspen 9" (12") S120 $^{\circ}$ W 24.5 links (25.5 links) Scribing grown over.

Description of monument and accessories I established to perpetuate the original location of this corner.

Replaced 4" oak post with 1 $\frac{1}{2}$ " O.D. iron pipe with 2" brass cap stamped - S498
NBT's - white birch 6" S82 $^{\circ}$ W 38.7 links Scribed 1/16 BT. White birch 5" S17 $^{\circ}$ E 43.4 links Scribed 1/16 BT. T37N R11E
WC-1/16 S 18

CPI-1975

Dated at Rhinelander, Wis., this 10th day of July, 1975.

Signature Philip T. Hansen Title Registered Land Surveyor Registration No. S-498
(County Surveyor, Registered Land Surveyor, or other duly authorized official)

Office of Register of Deeds, County of Oneida
Instrument was filed in his office for record on the 1st day of October 1975 at 3:00 o'clock P. M.

Doris Berger Kuehn
(Register of Deeds)

By Doris Berger Kuehn Deputy

02007811112