

CERTIFIED LAND CORNER RESTORATION

Index No. **K-3**

State of Wisconsin

County of Oneida } ss.

I, Phillip T. Hansen, do hereby certify that on the 17th day of February, 1978, I found evidence of the NC 1/16 corner of Section 18 Township 37, North, Range 11 East, Fourth Principal Meridian,



as described hereon; and that from this evidence I established a new monument and accessories as described hereon to perpetuate the original location of this corner.

Resident witnesses:

Glen Barker

Jim Claflin

Herb Wagoner

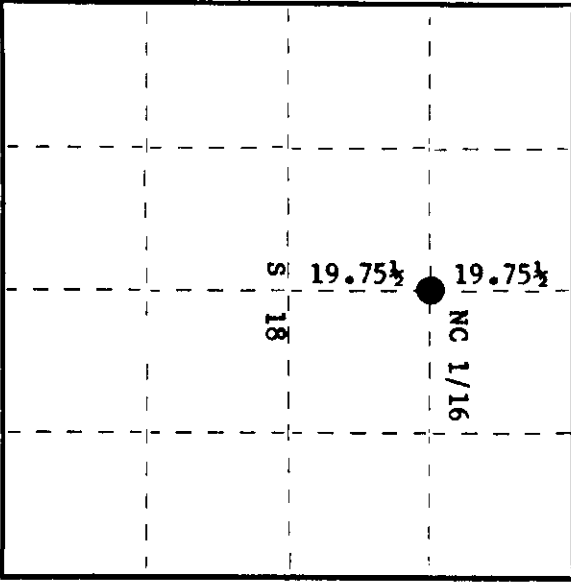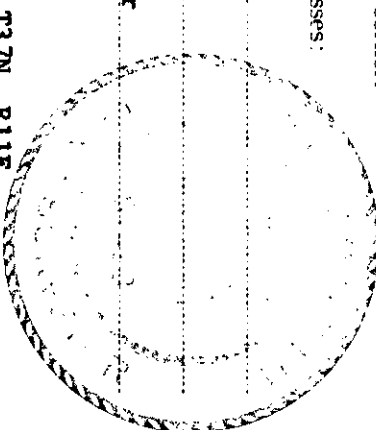

○ = Corner monument restored.

History of original corner establishment:

Corner established by H.C. Lawrence, Registered Land Surveyor, in 1949. Ran N 2° 20' E magnetic from C 1/4 39.09 chains intersect random line between 7 and 18 at 40.96 chains west. Set oak post 3 links east of 19.75 1/2 chains intermediate and marked BT - white birch 7" S73°W, 19 links; white birch 8" N20°W, 47 links.

Description of corner evidence found:

Recovered 6" oak post squared and scribed NC 1/16 - S18 - NC 1/16 - S18, standing in poor condition.

Recovered OBT's - white birch 7" S73°W (S78°W) 19 links, now a 3' stub, scribed NBT. white birch 8" (10") N20°W, 47 links, scribing grown over.

Description of monument and accessories I established to perpetuate the original location of this corner. Replaced 6" oak post with 1 1/2" iron pipe with 2" brass cap, stamped: Projects 18" above ground.

NBT's - maple 10" N40°W, 37.6 links, S498 scribed 1/16 BT. T37N R11E white birch 8" S70°E, 56.3 links, NC 1/16 S 1/8 scribed 1/16 BT. CPI-1978

Dated at Rhineland, Wis., this 7th day of March, 1978.

Signature Phillip T. Hansen Title Registered Land Surveyor Registration No. S-498
(County Surveyor, Registered Land Surveyor, or other duly authorized official)

Office of Register of Deeds, County of Oneida, I hereby certify that the within instrument was filed in this office for record on the 13th day of March, 1978 at 2:30 o'clock P.M.

Dorcas Leary Kuehn
(Register of Deeds)

By _____ Deputy

3711183020