

CERTIFIED LAND CORNER RESTORATION

Index No. **R-5**

State of Wisconsin }
 County of Oneida } ss.



I Philip T. Hansen, do hereby certify that on the 2nd day of September, 1976, I found evidence of the Section corner of 29, 20, 22, 36 Township 11 East, North, Range 11 East, Fourth Principal Meridian, as described hereon; and that from this evidence I established a new monument and accessories as described hereon to perpetuate the original location of this corner.

Resident witnesses:

Allen Barker

Jim Blain

Herb Connor

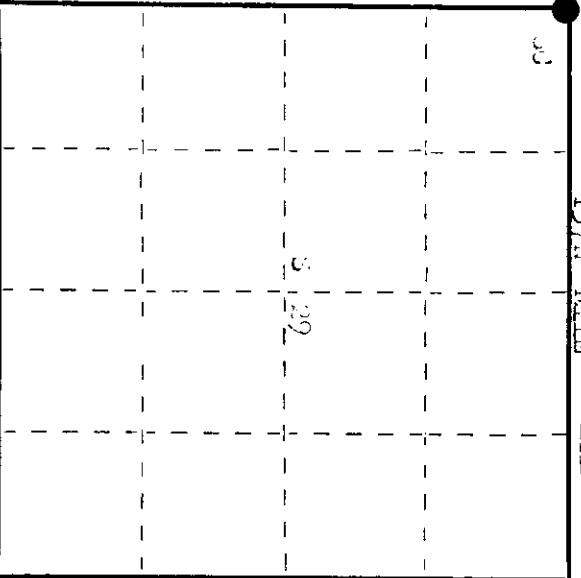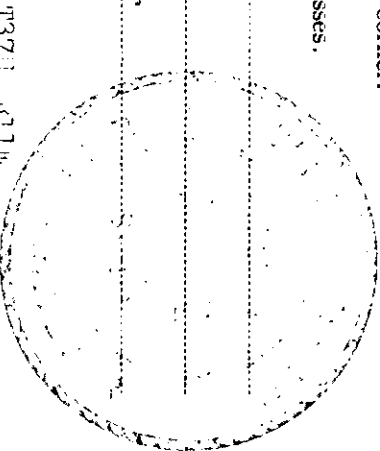

○ = Corner monument restored.

History of original corner establishment: Original corner established by ... surveyor, in 1859, from which bears 120° bears 120° to 22° links and cedar stump bears 30° to 12 links. Corner recovered by J.J. Helendy, Uagen Lumber & Cedar Company surveyor, in 1916, recovered original bearing trees and set new cedar post in place of old one. Marked BT's - circa 120° to 30° to 46 links, headlock 10" to 52° to 52 links. Corner recovered by H.C. Lawrence, registered land surveyor, in 1951. recovered original BT's and Helendy's bearing trees all in poor condition. set new post and marked new - cedar stub to 75° to 75 links and cedar stump to 35° to 47 links.

Description of corner evidence found: recovered Helendy's 4" cedar post, squared and scribed 29, 529, other sides not legible. recovered H.C. Lawrence's 4" cedar post squared and scribed 29, 220, 229, 230. Also found a 2" iron pipe with brass cap scribed 29, 220, 229, 230, believed to have been set by ... All three corners are in a radius of 2 links. recovered BT's - Helendy's circa 120° to 30° to 46 links, now a 10" stub. Headlock 10" to 52° to 52 links, now dead and decayed. Lawrence's cedar stub to 75° to 75 links (46 links) scribed 29 BT. Cedar stub to 35° to 47 links, scribed 29 BT. Helendy's post was oldest and checked calls to BT, decided to set new monument in its place.

Description of monument and accessories I established to perpetuate the original location of this corner. replaced Helendy's post with 2" diameter steel monument stumped: removed Helendy's iron pipe and Lawrence's wood post and set beside new monument. marked BT's - Black ash 6" to 31° to 57.4 links, scribed 29 BT. Black ash 6" to 90° to 52.4 links, scribed 29 BT. corner sets in the south edge of bog along swamp. no other suitable trees for BT. monument and BT's painted blue.

137.111
 5.29
 sec. 20 29

Dated at Oneida, Wis., this 7th day of September, 1976.
 Signature *Philip T. Hansen* Title: Registered Land Surveyor or other duly authorized official Registration No. 498
 (County Surveyor, Registered Land Surveyor, or other duly authorized official)

Office of Register of Deeds, County of Oneida. I hereby certify that the within instrument was filed in this office for record on the 9th day of November, 1976 at 10:30 o'clock A.M.

Louis George Kuehn
 (Register of Deeds)

By Deputy