

CERTIFIED LAND CORNER RESTORATION

Index No. **R-4**

State of Wisconsin


County of Cneida } ss.

I, Phillip T. Hansen, do hereby certify that on the 9th day of August, 1977, I found evidence of the E 1/16 corner of Section 19 & 30 Township 37, North, Range 11 East, Fourth Principal Meridian, as described hereon; and that from this evidence I established a new monument and accessories as described hereon to perpetuate the original location of this corner.


Resident witnesses:

Jim Clafflin

Herb Wagner

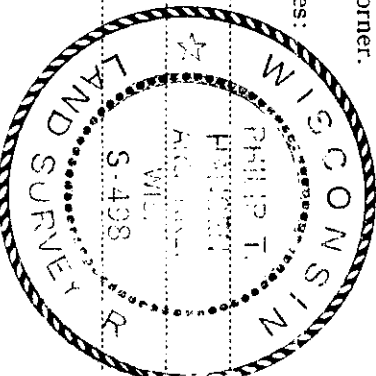

T37N R11E

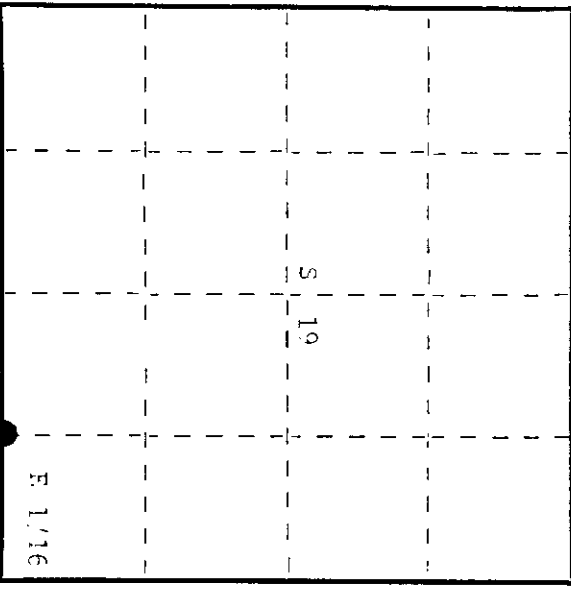

○ = Corner monument restored.

History of original corner establishment: Corner established by V.M. Maine, County Surveyor, which was set in an erroneous location. Maine ran his random line west from Section Corner 19, 20, 31 & 30 to his established corner 19, 24, 25 & 30 which was 2.19 chains south of its true position which was 50 links north of the N.C. on south shore of lake. H.C. Lawrence, Registered Land Surveyor, set the 1/16 corner and marked NBTs - Herlock 12" S29°E, 60 links and Aspen 12" S31°N, 57.5 links. He had recovered two very old stakes, one of which he believed original, for the N.C. on the south shore of Ginty Lake which he used to determine the section corner to which he ran his north random line between Section 19 & 30.

Description of corner evidence found:

Recovered 5" square cedar post, scribed E 1/16 S30, F 1/16 S19, in very poor condition and ready to fall.

Recovered GBTs - Herlock 12" (14") S29°E, 60.0 links. Aspen 12" (20") S31°N, 57.5 links, scribed E 1/16.

Description of monument and accessories I established to perpetuate the original location of this corner.

Replaced point of 5" cedar post with 1 1/2" iron pipe with 2" brass cap, stamped: Monument projects 24" above ground.

Marked NPTs - White Spruce 3" N30°W, 30.1 links, scribed 1/16 BT. T37N R11E  
Maple 4" S55°W, 62.6 links, scribed 1/16 BT. F 1/16 S19  
S498 - 1977

Dated at Pineland, Wis., this 11th day of August, 1977

Signature Phillip T. Hansen Title Registered Land Surveyor Registration No. 3-498  
(County Surveyor, Registered Land Surveyor, or other duly authorized official)

Office of Register of Deeds, County of Cneida  
Instrument was filed in this office for record on the 23rd day of August, 1977  
at 11:30 o'clock P. M. I hereby certify that the within

Doree Hansen Register  
(Register of Deeds)

By Deputy Deputy

3711190010