

OK  
RHW


CERTIFIED LAND CORNER RESTORATION

Index No. Q-5


State of Wisconsin }  
County of Oneida } ss.

I, Glen Barker, do hereby certify that on the 22nd day of August, 1983, I found ~~established~~ restored the corner of Sections 19 & 20 Township 37 North, Range 11 East, Fourth Principal Meridian, as described hereon; and that from this evidence I established a new monument and accessories as described hereon to perpetuate the original location of this corner.

Resident witnesses:  
J. Clafflin, Reg. Land Surveyor  
H. Wagoner  
BARKER  
S-1682  
CRANDON  
WI

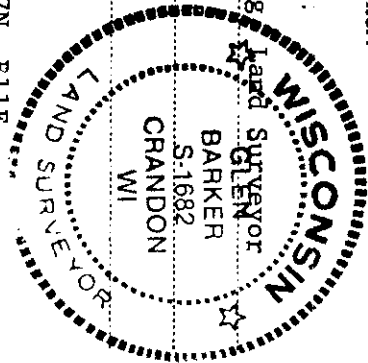

T37N R11E

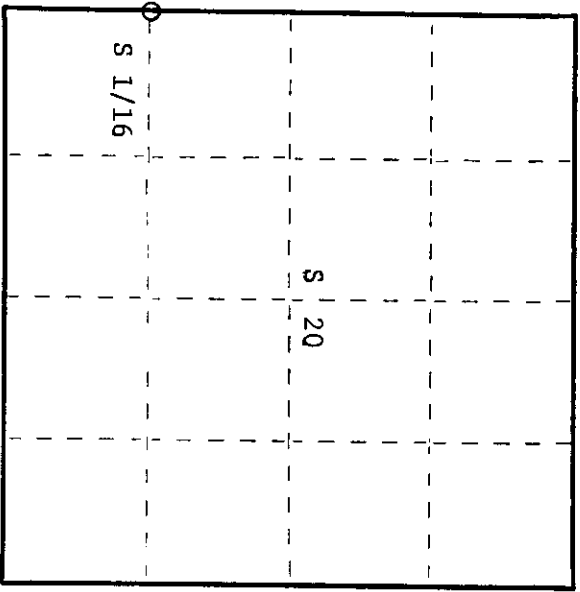

O = Corner monument restored.

History of original corner establishment:

No evidence of any previous corner.

Description of corner evidence found:

Total distance from section corner 19-20-29-30 to re-established 1/4 between sections 19 & 20 is 2669.64 feet. Set S 1/16 1334.82 feet intermediate.

Description of monument and accessories I established to perpetuate the original location of this corner.

Set a 1" x 30" iron pipe flush with the ground.  
Corner sets on east edge of field.  
Marked NBT's:

- Sugar (clump) 4" N54E 56.23 feet
- Sugar 3" N82E 59.30 feet
- scribed 1/16 - B.T.

Dated at Rhineland, Wis., this 29th day of September, 1983

Signature Glen Barker Title Registered Land Surveyor Registration No. S-1682  
(County Surveyor, Registered Land Surveyor, or other duly authorized official)

Office of Register of Deeds, County of Oneida 3rd day of November, 1983  
I hereby certify that the within instrument was filed in this office for record on the 11<sup>00</sup> o'clock a M.

Doris George Tuck  
(Register of Deeds)

By: \_\_\_\_\_ Deputy

371119/000