

CERTIFIED LAND CORNER RESTORATION

Index No. **Q-3**

State of Wisconsin

County of Oneida


ss.

I, Philip T. Hansen, do hereby certify that on the 3rd day of August, 1977, I found evidence of the SC 1/16 corner of Section 19 Township 37, North, Range 11, East, Fourth Principal Meridian, as described hereon; and that from this evidence I established a new monument and accessories as described hereon to perpetuate the original location of this corner.


Resident witnesses:

Jim Clafflin

Herb Kagoner

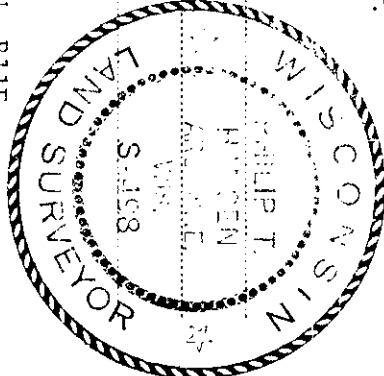

T37N R11E

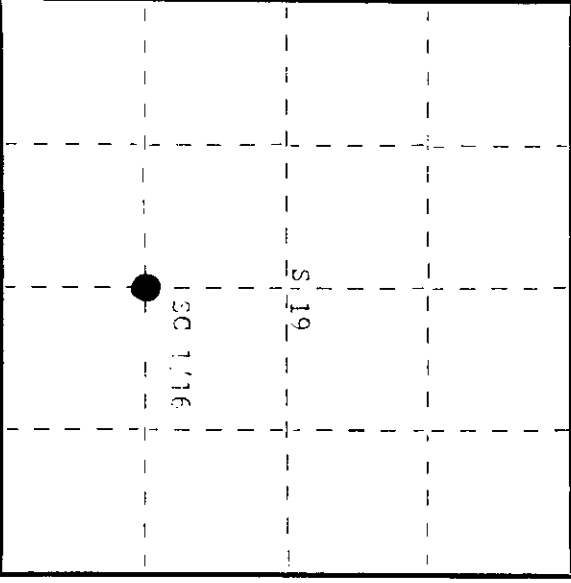

○ = Corner monument restored.

History of original corner establishment:

Corner established by H.C. Lawrence, Registered Land Surveyor, in 1951. Ran random line south from Vaughan's recovered C 1/4 to 1/4 corner between Section 19 & 30. Set new post, but no mention of any PTs.

Description of corner evidence found:

Recovered cedar post, down and badly decomposed. Rock cairn around base and recovered point of old post in center. Corner sets in an old 500 line gravel pit.

Description of monument and accessories I established to perpetuate the original location of this corner.

Replaced point of old post with 1 1/2" iron pipe with 2" brass cap, stamped: Monument projects 24" above ground. Marked MPTs - White Birch 7" S78°0', 49.7 links, scribed 1/16 ST. T37N R11E White Birch 7" S30°E, 10.7 links, scribed 1/16 PT. SC 1/16 S 1/2 S49° - 1977

Dated at Phineland, Wis., this 11th day of August, 1977

(County Surveyor, Registered Land Surveyor, or other duly authorized official)

Office of Register of Deeds, County of Oneida I hereby certify that the within instrument was filed in this office for record on the 29th day of August, 1977 at 1:15 o'clock P. M.

Doreen Haroge Keefer
(Register of Deeds)

By: _____ Deputy

3711191020