

CERTIFIED LAND CORNER RESTORATION



P 3 Index No. P-3

State of Wisconsin

County of Oneida } ss.

I Philip T. Hansen do hereby certify that on the 19th day of June, 1975, I found evidence of the C-1/4 corner of Section 19, Township 37 North, Range 11 East, Fourth Principal Meridian, as described hereon; and that from this evidence I established a new monument and accessories as described hereon to perpetuate the original location of this corner.

Resident witnesses.

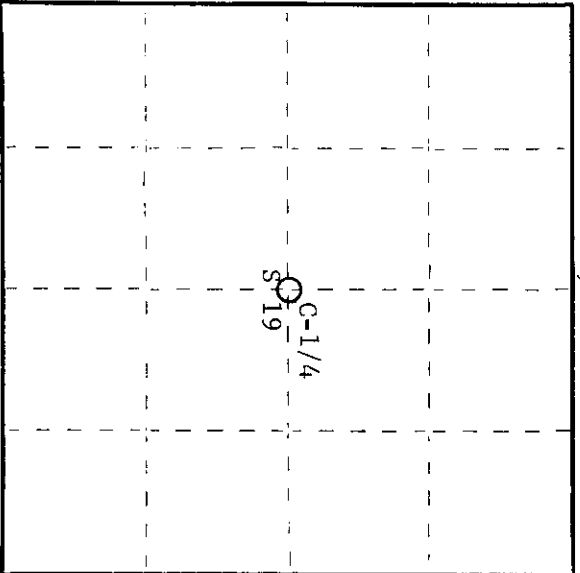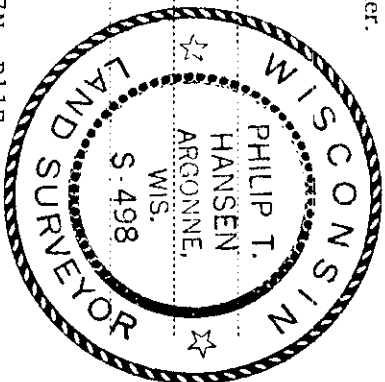

O = Corner monument restored.

History of original corner establishment:

Established by D.H. Vaughan, County Surveyor, in 1898. Set tamarack BT S56 1/2° W, 17 links. Corner recovered and restored by H.C. Lawrence, Registered Land Surveyor, in 1951. Recovered Vaughan's old post and tamarack BT. Distance and bearing checked. Set new cedar post 3'6" high and made NBT. Cedar stump 8", S77° E, 27 links.

Description of corner evidence found:

Recovered H.C. Lawrence's 3" cedar post, squared and scribed C-1/4 S19, G-1/4 S19, in fair condition.
 Recovered OBT's - Tamarack 12" S56°30'W 17 links (Vaughan's) now decayed
 Cedar stump 8" S77°E 27 links now decayed
 Found point of Vaughan's old stake when we pulled out Lawrence's post.

Description of monument and accessories I established to perpetuate the original location of this corner.

Replaced Lawrence's cedar post with 2 1/2" iron pipe with brass cap stamped - S498 T37N, R11E
 NBT's - Black spruce 5" S26°W 30.5 links scribed 1/4 BT
 Black ash 5" East 35 links scribed 1/4 BT C-1/4 S19

Drove old point down beside new iron pipe and set Lawrence's post next to it. CPI-1975

Dated at Rhineland, Wis., this 15th day of July, 1975.

Signature: *Philip T. Hansen* Title: Registered Land Surveyor Registration No. S-498
 County Surveyor, Registered Land Surveyor, or other duly authorized official

Office of Register of Deeds, County of Oneida
 Instrument was filed in this office for record on the 1st day of October, 1975 at 3:00 o'clock P.M.

Doris Terape Bucher
 (Register of Deeds)

By: _____ Deputy

3711192040