

CERTIFIED LAND CORNER RESTORATION

Index No. **R-6**

State of Wisconsin

County of Oneida } ss.



I Phillip T. Hansen, do hereby certify that on the 2nd day of September, 1976, I found evidence of the 1/16 corner of Section 20 - 29 Township 37, North, Range 11 East, Fourth Principal Meridian, as described hereon; and that from this evidence I established a new monument and accessories as described hereon to perpetuate the original location of this corner.

Resident witnesses:

Glen Parker

Jim Clufflin

Herb Peterson

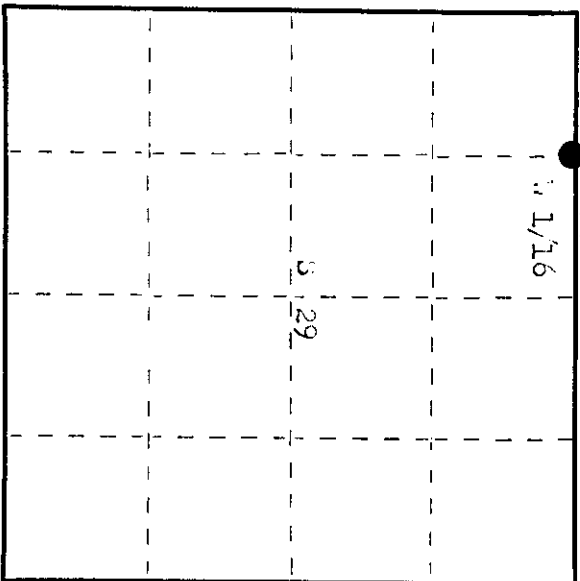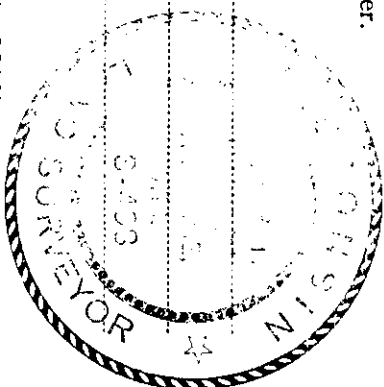

○ = Corner monument restored.

History of original corner establishment:
Origin of this Corner unknown.

H. O. Lawrence refers in his notes to starting from a 1/16 corner and running line south to determine the 1/16 corner of section 29.

Lawrence refers to OBT's on his map - black spruce 4" x 45" x 21 links and black spruce 4" x 45" x 40 links.

Description of corner evidence found:

recovered 3" cedar stake, squared and scribed 1/80 in very poor condition.

recovered OBT - black spruce 4" x 45" x 21 links, now dead, scribed 1/80 BT.

Lawrence signature? scribed to its 9" x 40" x 1/16.
black spruce 4" x 45" x 40 links, now a decayed stump.

Description of monument and accessories I established to perpetuate the original location of this corner.

replaced old post with 1 1/2" w iron pipe with 2" brass cap stamped:

monument projects 18" above ground.
OBT's - Tamarack 6" x 60" x 28.8 links, scribed 1/16 BT.
Black spruce 7" x 42" x 70.4 links, scribed 1/16 BT.

498
T37N R11E
S 29
1/16
OP1-1976

Dated at Rhinelander, Wis., this 7th day of September, 1976

Signature Phillip T. Hansen Title Registered Land Surveyor Registration No. 3448
(County Surveyor, Registered Land Surveyor, or other duly authorized official)

Office of Register of Deeds, County of Oneida
Instrument was filed in this office for record on the 29th day of September, 1976
at 2:30 o'clock P.M. Phillip T. Hansen hereby certifies that the within

Debra Verage Kuehn
(Register of Deeds)

By: _____ Deputy

311200030