

OK  
PFW

CERTIFIED LAND CORNER RESTORATION

Index No. Q-7


State of Wisconsin }  
County of Oneida } ss.

History of original corner establishment:  
  
No evidence of any previous corner.

I Glen Barker, do hereby certify that on the 22nd day of August, 1983, I ~~reestablished~~ reestablished the SC 1/16 corner of Section 20, Township 37, North, Range 11 East, Fourth Principal Meridian, as described hereon; and that from this evidence I established a new monument and accessories as described hereon to perpetuate the original location of this corner.


Resident witnesses:

J. Clafin, Reg. Land Surveyor  
H. Wagoner

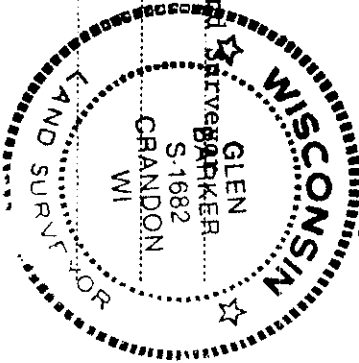

Description of corner evidence found:  
  
Total distance from 1/4 corner between sections 20 & 29 to C 1/4 position is 2657.84 feet.  
Set SC 1/16 1328.92 feet intermediate.

Description of monument and accessories I established to perpetuate the original location of this corner.  
Set a railroad spike 5.0 feet east of centerline Gagen Road for true corner.  
Set a 1" iron pipe with 2" diameter alloy cap, stamped:  
Monument projects 18" above ground.  
Marked NBT's to true corner:  
Tamarack 6" S70W 46.43 feet ) 1/16 - B.T. SC 1/16 S 1/20 R.C.  
Black Spruce 4" N58W 51.32 feet ) E. 40 Ft.  
CPI - 1983

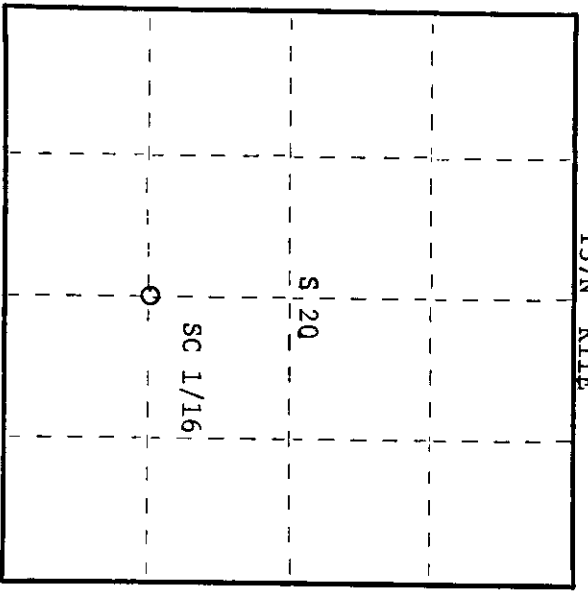

Dated at Rhineclander, Wis., this 29th day of September, 1983.  
Signature: Glen Barker Title: Registered Land Surveyor Registration No. S-1682  
(County Surveyor, Registered Land Surveyor, or other duly authorized official)

Office of Register of Deeds, County of Oneida  
Instrument was filed in this office for record on the 3rd day of November, 1983 at 11:08 o'clock a. M.  
Dorva Lange Lueth  
(Register of Deeds)

By: \_\_\_\_\_ Deputy

3711201026