

CERTIFIED LAND CORNER RESTORATION



Index No. P-9

State of Wisconsin } ss.
 County of Oneida

I Philip T. Hansen, do hereby certify that on the 11th day of April, 1979, I found evidence of the Quarter corner of Section 20, T21 Township 37 North, Range 11 East, Fourth Principal Meridian, as described hereon; and that from this evidence I established a new monument and accessories as described hereon to perpetuate the original location of this corner.

Resident witnesses:

Jim Clafflin
Herb Wagoner

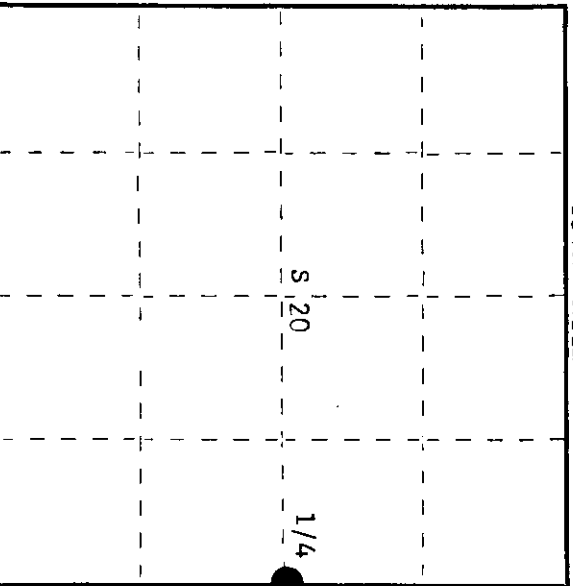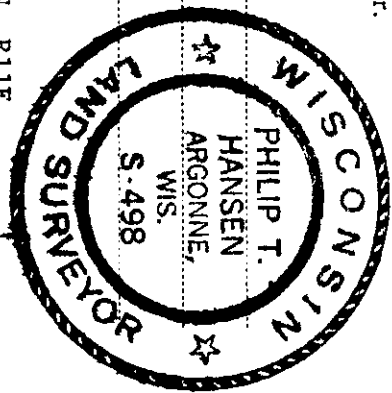

○ = Corner monument restored.

CERTIFIED LAND CORNER RESTORATION

Index No. P-9

History of original corner establishment:
 The original corner established by Wm. E. Dougherty, Deputy Surveyor, in 1859, from which spruce 7" bears N20°W, 25 links; spruce 6" bears S40°E, 18 links. This corner re-established by V.M. Maine in 1937. Set his iron pipe at equidistance measure. Set iron pipe but marked no BT's.

H.C. Lawrence, Registered Land Surveyor, ran this line in 1949 and found a very old stake, 52 links south of Maine's iron pipe. Lawrence also ran the E-W 1/4 line, projecting his centerline of the E-W road east and fell one link south of the old post. Because of this he accepted the old stake in preference to Maine's iron pipe.

Marked NBT - Tamarack 7" N42°W 3.33 chains.

Description of corner evidence found:
 Recovered H.C. Lawrence's squared cedar post, scribed 1/4S S20, S21. Also recovered very old post scribed 1/4.
 Recovered Maine's iron pipe N7°E 51.6 links.
 Recovered OBT - Tamarack 7" N42°W 3.33 chains

Description of monument and accessories I established to perpetuate the original location of this corner.

Replaced cedar post with 2 1/2" Berntsen A-1 Federal Monument projecting 1 1/2' above ground.

Cap stamped:

Marked NBT's - Black Spruce 6" N41°W 330.6 links
 Tamarack 4" N79°W 335.5 links
 Tamarack 6" S17°E 274.0 links
 2 1/2" iron pipe N7°E 51.6 links (Maine's)
 Corner sets in a large spruce and leather leaf bog.
 T37N R11E
 1/4 S20 + S21
 S498 - 1979

Dated at Rhineland Wis. this 24th day of April, 1979

Signature Philip T. Hansen Title Registered Land Surveyor Registration No. S-498
 (County Surveyor, Registered Land Surveyor, or other duly authorized official)

Office of Register of Deeds, County of Oneida I hereby certify that the within instrument was filed in this office for record on the 14th day of May, 1979 at 1:30 o'clock P. M.

Jesse Bergey Hueshn
 (Register of Deeds)

By Jesse Bergey Hueshn Deputy