

CERTIFIED LAND CORNER RESTORATION

Index No. **R-11**



State of Wisconsin

County of **Oneida** } ss.

I **Phillip T. Hansen**, do hereby certify that on the **6th** day of **February**, 19**78**, I found evidence of the **Quarter** corner of **Sections 21 & 28** Township **37**, North, Range **11 East**, Fourth Principal Meridian, as described hereon; and that from this evidence I established a new monument and accessories as described hereon to perpetuate the original location of this corner.

Resident witnesses:

**Glen Barker**  
**Jim Clafflin**  
**Herb Wagoner**

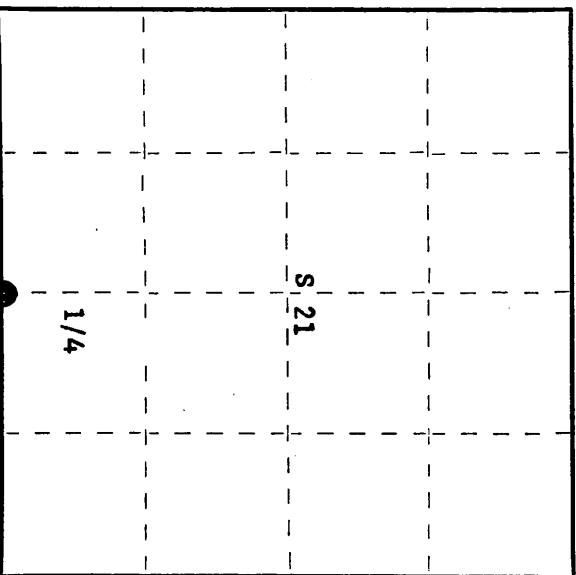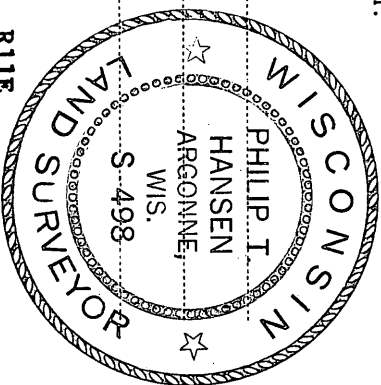

○ = Corner monument restored.

History of original corner establishment:  
Original corner established by Wm. E. Dougherty, Deputy Surveyor, in 1859 from which Birch 6" bears S 20° W, 5 links and Birch 8" bears N 48° W, 25 links.  
Corner re-established by V.M. Maine, County Surveyor, in 1937 - set new post and marked NBT's - White Birch 5" S77°W, 47 links and Aspen 4" N54°E, 16 links.  
Corner recovered by H.C. Lawrence, Registered Land Surveyor, in 1950.

Description of corner evidence found:

Recovered 2 1/2" iron pipe with brass cap in good condition projecting 2' above ground.  
Cap stamped:

No evidence remains of Maine's BT's.

T37N R11E  
S21  
1/4  
S28

Description of monument and accessories I established to perpetuate the original location of this corner.

Monument left in place as recovered.  
Marked NBT's - White Spruce 6" S19°W, 16.6 links  
White Spruce 5" N46°W, 40.5 links  
White Birch 8" N36°E, 18.2 links  
White Birch 9" S39°E, 37.7 links  
all scribed 1/4 BT.  
Corner sets approximately 5 chains north of Soo Line RR.

Dated at **Rhinelander**, Wis., this **7th** day of **February**, 19**77**.

Signature **Phillip T. Hansen** Title **Registered Land Surveyor** Registration No. **S-498**  
(County Surveyor, Registered Land Surveyor, or other duly authorized official)

Office of Register of Deeds, County of **Oneida**  
Instrument was filed in this office for record on the **8th** day of **February**, 19**78**  
at **2:45** o'clock **P.** M.

**Dorcas Venage Fuchs**  
(Register of Deeds)

By \_\_\_\_\_ Deputy

3711210020