

CERTIFIED LAND CORNER RESTORATION

Index No. R-10

State of Wisconsin


County of Oneida } ss.

History of original corner establishment:
Corner established in 1935 by V.M. Waine, county surveyor.

I, Phillip T. Hansen, do hereby certify that on the 23rd day of June, 1980, I ~~found~~ established the W 1/16 corner of Sections 21 and 28 Township 37, North, Range 11 East, Fourth Principal Meridian, as described hereon; and that from this evidence I established a new monument and accessories as described hereon to perpetuate the original location of this corner.

Resident witnesses:

Glen Barker
Jim Clafflin
Herb Wagoner

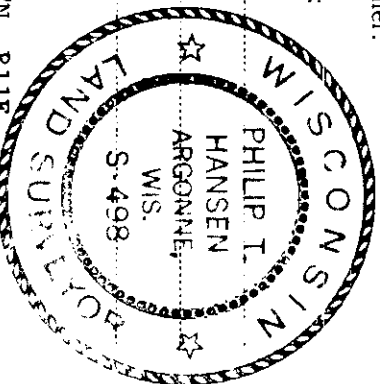


Description of corner evidence found:

Maine's 4" squared cedar post bears N80°E 6.95' from new position of resurvey. Corner established by proportion. Ran traverse from previously established section corner 20, 21, 28, 29 to 1/4 corner between sections 21 and 28 for a distance of 2757.19 feet at bearing N 88° 33' 47" W.
Set W 1/16 corner 1378.60 feet intermediate.

Description of monument and accessories I established to perpetuate the original location of this corner.

Set a 1-1/2" iron pipe with 2" brass cap, stamped:
Monument projects 24" above ground.
Marked NBT -
Twin Maple 10" N36°E 78.22 feet
scribed 1/16 BT.
B.O. - telephone pole S81°E 41.64 feet.

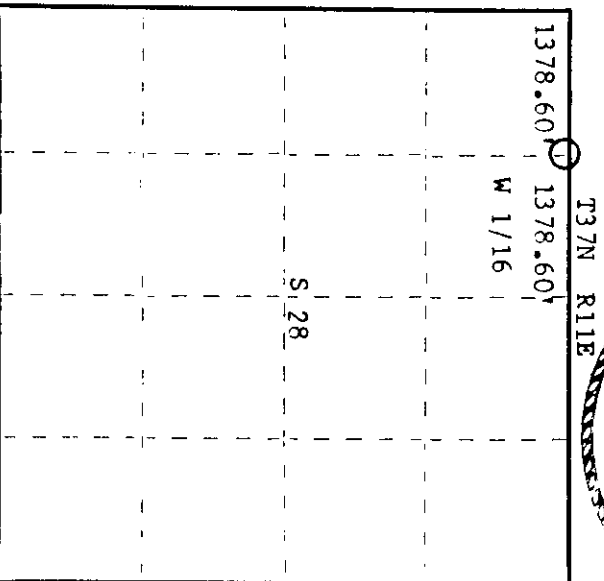

○ = Corner monument restored.

Dated at Rhineland, Wis. this 23rd day of July, 1980.

Signature Phillip T. Hansen Title Registered Land Surveyor Registration No. S-498
(County Surveyor, Registered Land Surveyor, or other duly authorized official)

Office of Register of Deeds, County of Oneida
at 10:15 o'clock 30th day of July, 1980.
I hereby certify that the within

Donna George Fuller
(Register of Deeds)

By Donna George Fuller Deputy

3710210030