

CERTIFIED LAND CORNER RESTORATION



P 13
Index No. P-13

State of Wisconsin

County of Oneida } ss.

I Phillip T. Hansen, do hereby certify that on the 30th day of April, 1975, I found evidence of the Quarter corner of Sections 21 and 22 Township 37 North, Range 11 East, Fourth Principal Meridian, as described hereon; and that from this evidence I established a new monument and accessories as described hereon to perpetuate the original location of this corner.

Resident witnesses:

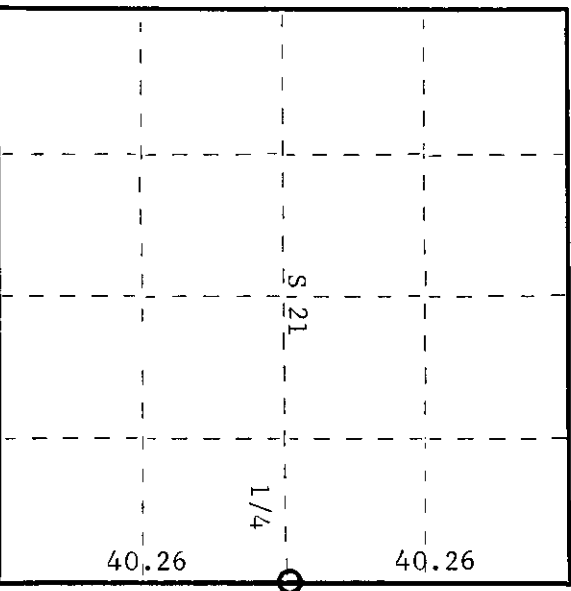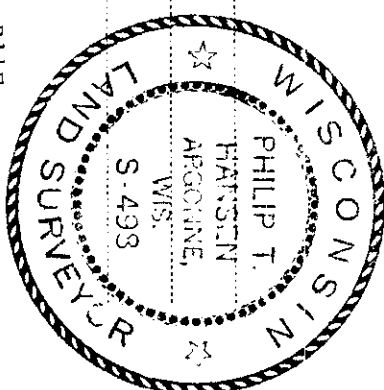

History of original corner establishment:

Original corner established by Wm. E. Dougherty, Gov. Deputy Surveyor, in 1859, from which Fir 6" bears N80°E, 7 links and birch 9" bears S200°W, 25 links.
 Corner re-established by J.A. Melendy, Gagen Lumber Co. Surveyor, in 1916. Set a 7" x 7" cedar post with stone placed around it at surface, from which a pine stump 36" bore S37-3/4°W at 63-3/4" and pine stub 36" bore S53-1/4°E, 40 links.
 Corner established by V.M. Maine, County Surveyor, but he did not tie into existing 1/4 corner set by Melendy. Maine set a 2-1/2" iron pipe stamped T37N R11E 1/4C S21-S22. Corner restored by H.C. Lawrence in 1949. Recovered pine stumps set by Melendy and located corner by intersection; set NBT - aspen 10" N52°E, 55 links. This corner is equidistant between NW and SW corner of Section 22 at 40.26 chains.
 Description of corner evidence found:
 Recovered H.C. Lawrence's 4" cedar post, squared and scribed S-1/4 S21, S-1/4 S2. Also found an old cedar post, squared and scribed S-1/4 S21; S-1/4 S22 and a well point set beside Lawrence's post. The latter found in poor condition.
 Also found V.M. Maine's 2-1/2" iron pipe N80°W, 109.2 links; stamped T37N R11E 1/4 S21, S22.
 No old bearing trees were recovered.

Description of monument and accessories I established to perpetuate the original location of this corner.
 Replaced Lawrence's 4" cedar post, the old 6" post, and well pipe with a 2-1/2" iron pipe with brass cap stamped -

NBT's - Cedar	8"	S82°W	159 links	scribed 1/4 BT	T37N, R11E	5498
Cedar	6"	N41°E	115.5 links	scribed 1/4 BT	1/4 S21 S22	GPT-1975

Dated at Rhineland, Wis., this 19th day of May, 1975.

Signature *Phillip T. Hansen* Title Registered Land Surveyor Registration No. S-498
 County Surveyor, Registered Land Surveyor, or other duly authorized official

Office of Register of Deeds, County of Oneida
 Instrument was filed in this office for record on the 1st day of October, 1975 at 3:00 o'clock P.M.

Donie Burgess Tucker
 (Register of Deeds)

By _____ Deputy