

CERTIFIED LAND CORNER RESTORATION

Index No. **R-16**



State of Wisconsin }
 County of Oneida } ss.

I Phillip T. Hansen do hereby certify that on the 29th day of October, 1975, I found evidence of the E-1/16 corner of Sections 22 and 27 Township 37 North, Range 11 East, Fourth Principal Meridian, as described hereon; and that from this evidence I established a new monument and accessories as described hereon to perpetuate the original location of this corner.

Resident witnesses:

Glen Barker
 Jim Claflin

T37N R11E

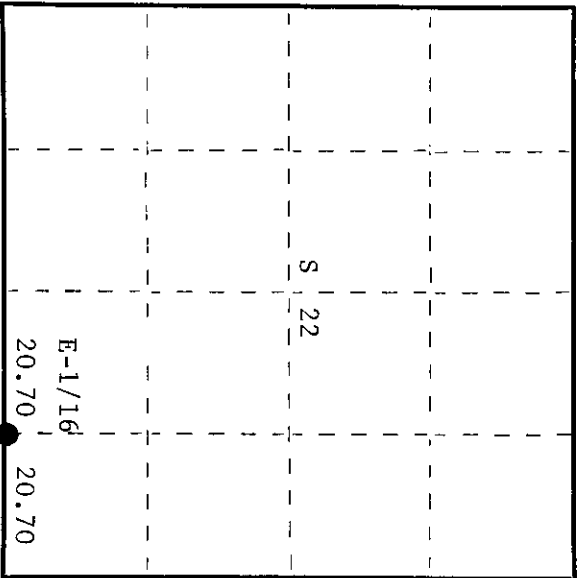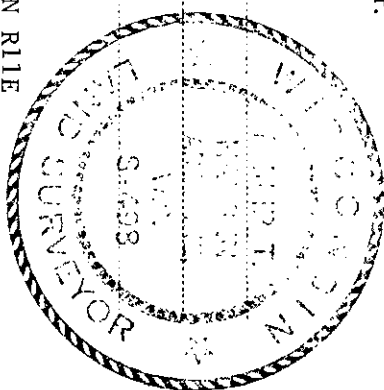

○ = Corner monument restored.

History of original corner establishment:

Corner established by H.C. Lawrence, Registered Land Surveyor, in 1948. From recovered 1/4 corner between Sec. 22 and Sec. 27, he ran a random line 0°50'E var. and at 41.40 chains, was 41-1/2 links north of Section Corner, corrected bearing N89°44'E. Set E-1/16 corner at 20.70 chains, equidistant and 20-1/2 links south. Marked NBT's: Sugar 16" S46°W 189-1/2 links and Sugar 12" N77°E 100-1/2 links.

Description of corner evidence found:

Recovered 4" cedar post, squared and scribed S22 E-1/16 S27, in poor condition.
 Recovered OBT's: Sugar 16" (17") S46°W 189.5 links - scribed E-1/16 S27 BT,
 Sugar 12" N77°E 100.5 links - scribed E-1/16 S22 BT.

Description of monument and accessories I established to perpetuate the original location of this corner.

Replaced 4" wood post with 1" iron pipe with 2" brass cap stamped - S498
 Post projects 18" above ground. T37N R11E
 Post and BT's painted blue.
 No additional accessories established. E-1/16 S 22
 S 27
 CPI-1975

Dated at Rhinelander, Wis., this 4th day of October, 1975

Signature *Phillip T. Hansen* Title Registered Land Surveyor Registration No. S-498
 (County Surveyor, Registered Land Surveyor, or other duly authorized official)

Office of Register of Deeds, County of Oneida
 Instrument was filed in this office for record on the 29th day of October, 1975
 at 10:00 o'clock P.M. I hereby certify that the within

Norma L. Kinnage Kinnahan
 (Register of Deeds)

By Deputy

010022001