


CERTIFIED LAND CORNER RESTORATION

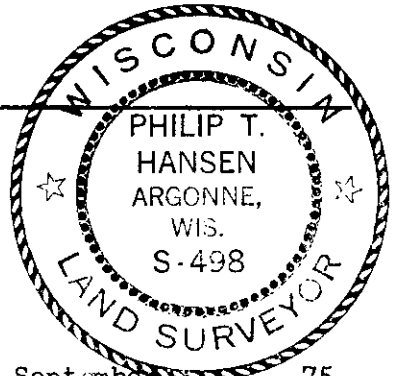

State of Wisconsin }
 County of Oneida } ss.

I Philip T. Hansen do hereby certify that on the 2nd day of September 19 75, I found evidence of the SC 1/16 corner of Section 22 Township 37 North, Range 11 East, Fourth Principal Meridian, as described hereon; and that from this evidence I established a new monument and accessories as described hereon to perpetuate the original location of this corner:

Description of original monument and accessories and subsequent restorations: Corner established by H.C. Lawrence, Registered Land Surveyor in 1950. From J.J. Melendy, Cagen Lumber Co. Surveyors $\frac{1}{4}$ corner, he ran a random line S 2°00' E a distance of 40.46 chains to intersect the south line 19 lks east of $\frac{1}{4}$ post. Set SC 1/16 at 20.23 chains, $9\frac{1}{2}$ lks west. No trees near for BTs.

Description of corner evidence found: Recovered 3" cedar post, squared and scribed SC 1/16 S 22 SC 1/16 S22 in poor condition.


No OBTS recovered

Description of monument and accessories I established to perpetuate the location of this corner: Replaced 3" cedar Post with $1\frac{1}{2}$ " OD iron pipe w/2" brass cap stamped

NBTs - Tamarack 6" N88°E 46.4 lks scribed 1/16 BT
 Tamarack 5" N16°W 27.5 lks, scribed 1/16 BT

S 498
 T 37 N R 11 E
 S 22
 SC 1/16
 CPI 1975

T 37 N R 11 E

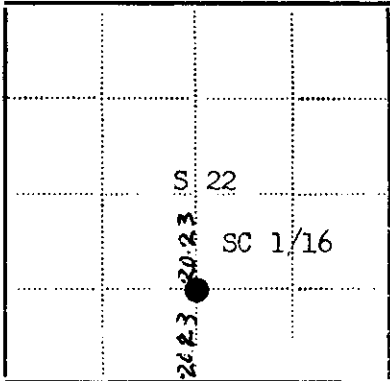

● - Corner monument restored
 □ -

Resident witnesses Glen Barker and Jim Claflin

Dated at Rhineland Wisconsin, this 16 day of September 19 75.

Signature Philip T. Hansen Title Registered Land Surveyor
 (County Surveyor, Registered Land Surveyor, or other duly authorized official)

Surveyors Registration No. S-498

Office of Register of Deeds County of Oneida

I hereby certify that the within instrument was filed in this office for record on the 14th day of October 19 75, and was filed in Book No. _____ Page No. _____ of County Records.

Signature Doris Verage Kuehn Title Register of Deeds

Township 37 North, Range 11 East, Section 22, Index No. _____, Page No. _____