

CERTIFIED LAND CORNER RESTORATION

P 14 Index No. P-114

State of Wisconsin

County of Oneida } ss.

I Philip T. Hansen, do hereby

certify that on the 6th day

of May, 1975, I found

evidence of the WC-1/16

corner of Section 22

Township 37 North, Range

11 East, Fourth Principal Meridian,


as described hereon; and that from this evidence

I established a new monument and accessories

as described hereon to perpetuate the original

location of this corner.

Resident witnesses:

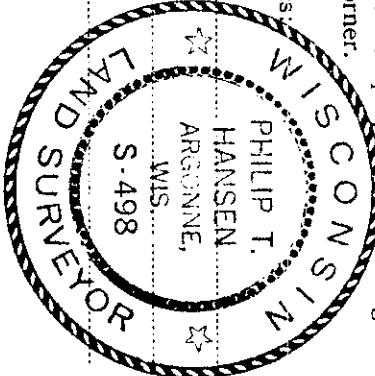

History of original corner establishment:  
Original corner established by H.C. Lawrence, Registered Land Surveyor, in 1949. He set corner equidistant (20.30) chains between G-1/4 corner and West 1/4 corner set by J.A. Melendy in 1916.

Description of corner evidence found:

Recovered 4" cedar post, squared and scribed WC-1/16 S22, WC-1/16 S22 in poor condition. A 1-1/2" iron pipe was set up beside it.


Recovered OBT: Tamarack 11" N41°E 28 links scribed WC-1/16 S22 NBT.

Description of monument and accessories I established to perpetuate the original location of this corner.

Replaced wooden cedar post with 1-1/2" OD iron pipe w/2" brass cap stamped -

NBT: Tamarack 5" N68°W 48.7 links scribed 1/16 BT.

S498  
T37N R11E  
WC-1/16 S/22  
CPT-1975

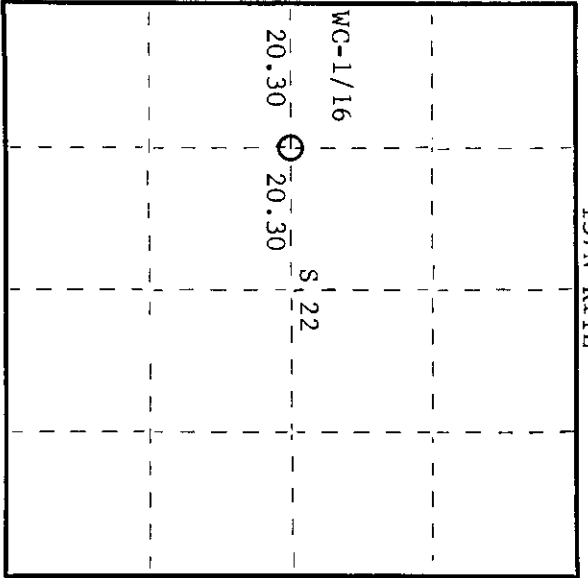

○ = Corner monument restored.

Dated at Rhinelander, Wis., this 3rd day of July, 1975

Signature *Philip T. Hansen* Title Registered Land Surveyor Registration No. S-498  
(County Surveyor, Registered Land Surveyor, or other duly authorized official)

Office of Register of Deeds, County of Oneida  
Instrument was filed in this office for record on the 1st day of October, 1975  
at 3:00 o'clock P.M. I hereby certify that the within

*Doris Sprague Tucker*  
(Register of Deeds)

By: Deputy

3711222030