

CERTIFIED LAND CORNER RESTORATION


Index No. **R-20**

State of Wisconsin } ss.
 County of Oneida

I Phillip F. Hansen do hereby
 certify that on the 3rd day
 of December, 1976, I found
 evidence of the E 1/16
 corner of Section 23 & 26
 Township 37, North, Range
11 East, Fourth Principal Meridian,

as described hereon; and that from this evidence
 I established a new monument and accessories
 as described hereon to perpetuate the original
 location of this corner.


Resident witnesses:
Glen Barker
Jim Claffin

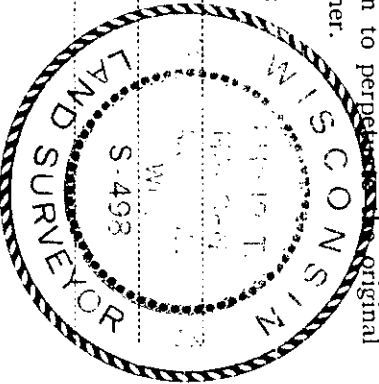

History of original corner establishment:
 Corner established by H.C. Lawrence, Registered Land Surveyor, in 1949.
 Ran a random line East (var. 0° 50' E) from recovered 1/4 corner a distance of 40.00
 chains to close out 50 links south of Section Corner. Set a 4" tamarack post at 20.00
 chains, intermediate and 25 links north.
 Marked NBTs - Tamarack 5" S 66° W 27 links and White Birch 9" N 38° E 50 links.

Description of corner evidence found:
 Recovered Lawrence's 4" tamarack post lying under brush.
 Also recovered a 1 1/2" iron pipe. Removed iron pipe and found tip of post along side
 and below iron pipe.
 The tamarack BT had been bulldozed out.
 Recovered OBT - White Birch 9" N 22° E 50 links (now a decayed stump.)

Description of monument and accessories I established to perpetuate the original location of this corner.
 Replaced point of old stake with 1 1/2" OD iron pipe with 2" brass cap stamped:
 Monument projects 2 1/4" above ground. S-498
 NBT - Maple 8" N 42° E 66 links, scribed 1/16 BT. T37N R1E
 Maple 8" S 64° W 75.2 links, scribed 1/16 BT. S 23
 Corner sets on the north edge of an old swamp road, recently re-opened. E 1/16 S 26
CPI-1976

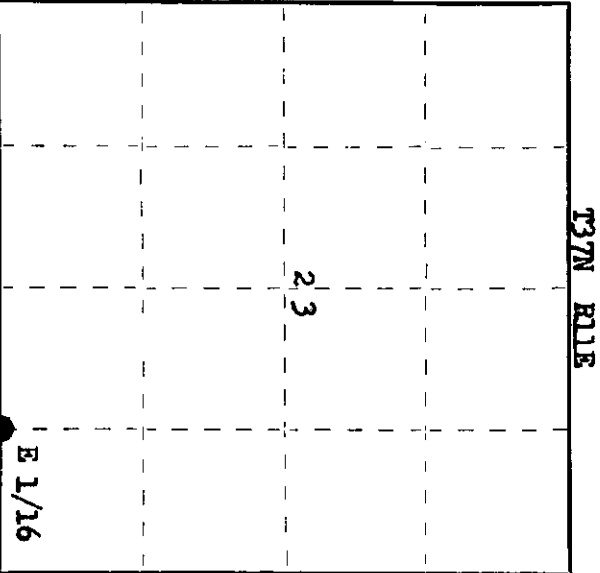

○ = Corner monument restored.

Dated at Oneida, Wis., this 3rd day of January, 1977

Signature Phillip F. Hansen Title Registered Land Surveyor Registration No. S-498
 (County Surveyor, Registered Land Surveyor, or other duly authorized official)

Office of Register of Deeds, County of Oneida
 Instrument was filed in this office for record on the 24th day of February, 1977
 at 10:00 o'clock P. M.

Debra Verage Kuehn
 (Register of Deeds)

By _____ Deputy

3711220010