

CERTIFIED LAND CORNER RESTORATION



Q 21 Index No. Q 21

371123/000

State of Wisconsin }  
County of Oneida } ss.

I Phillip T. Hansen do hereby certify that on the 24th day of June, 1975, I found evidence of the S-1/16 corner of Sections 23 and 24 Township 11 East, North, Range 37, Fourth Principal Meridian, as described hereon; and that from this evidence I established a new monument and accessories as described hereon to perpetuate the original location of this corner.

Resident witnesses:

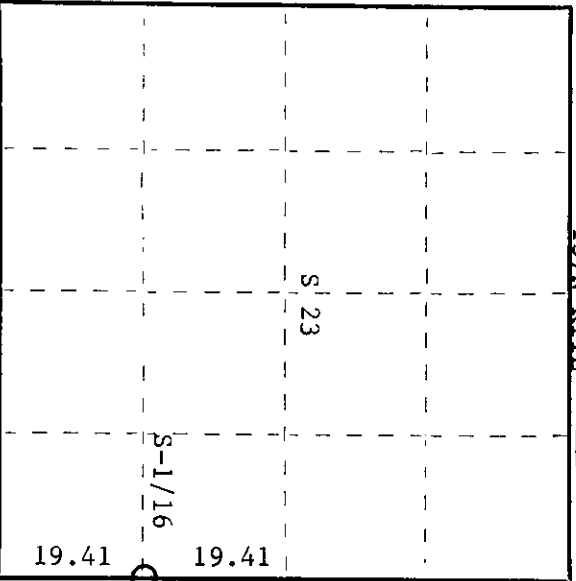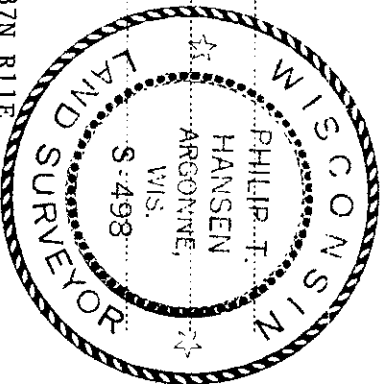

○ = Corner monument restored.

CERTIFIED LAND CORNER RESTORATION

History of original corner establishment:

Corner set by H.C. Lawrence during his retracement and subdivision survey in 1948. From the recovered section corner, S23, S24, 25, 26, which was the original corner, he ran a random line north (Var. 30°45'E) 38.82 chains to a point 81 links east at right angles to Melendy's 1/4 post which he established in 1916. Lawrence corrected line and set S-1/16 corner 40 1/2 links east at right angles from 19.41 chains intermediate. Made BT's - sugar maple 12" S75°E 15 links and yellow birch 10" S25°E 11 1/2 links. Bearing of true corrected line is N2°34'W. An old S-1/16 corner is 24 1/2 links too far east and 62 links too far north of the established corner.

Description of corner evidence found:

Recovered Lawrence's 3" cedar post, squared and scribed S-1/16 S23, S-1/16 S24, in fair condition.

Recovered OBT - Yellow birch 10" S25°E 11 1/2 links - scribed S-1/16 BT, now 20' stub.  
R. maple 12" (13") S75°E (S78°E) 15 links - scribed S-1/16 BT.

Description of monument and accessories I established to perpetuate the original location of this corner.  
Replaced 3" cedar post with 1-1/2" iron pipe with 2" brass cap stamped -

NBT - Black spruce 6" N15°W 30.5 links scribed 1/16 BT

S498  
T37N R11E

S-1/16	S23	S24
	CPI 1975	

Dated at Rhinelander Wis. this 17th day of July, 1975.

Signature: *Phillip T. Hansen* Title: Registered Land Surveyor Registration No. S-498  
(County Surveyor, Registered Land Surveyor, or other duly authorized official)

Office of Register of Deeds, County of Oneida. I hereby certify that the within instrument was filed in this office for record on the 1st day of October, 1975 at 3:00 o'clock P.M.

*Doris Savage Fuchs*  
(Register of Deeds)

By Deputy