

CERTIFIED LAND CORNER RESTORATION

Index No. **Q-19**

State of Wisconsin }  
 County of Oneida } ss.

History of original corner establishment: Original corner established by D.H. Vaughan, County Surveyor, from which spruce 10" bears S15°E, 17 links and cedar 10" bears N68°W, 17-1/2 links.

Corner recovered by H.C. Lawrence, Registered Land Surveyor, in 1946. Set a new cedar post in place of Vaughan's old post. BT's were still alive and intact.


I, Philip T. Hansen, do hereby certify that on the 5th day of December, 1975, I found evidence of the SC-1/16 corner of Section 23 Township 37, North, Range 11 East, Fourth Principal Meridian, as described hereon; and that from this evidence I established a new monument and accessories as described hereon to perpetuate the original location of this corner.

Description of corner evidence found: Recovered Lawrence's 4" cedar post, squared and scribed SC-1/16 Sec. 23 SC-1/16, in poor condition. Vaughan's old decayed post was lying on the ground beside it.

Resident witnesses:

Glen Barker

Jim Clafin

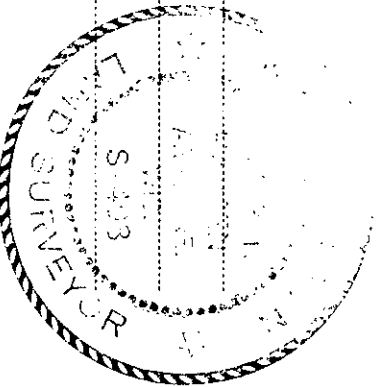


Recovered OBT - Spruce 10" S15°E 17 links now a decayed stump  
 Cedar 10" (14") N68°W (N62°W) 17.5 links scribed 1/8-S BT

Description of monument and accessories I established to perpetuate the original location of this corner.  
 Replaced 4" cedar post with 1-1/2" O.D. iron pipe with 2" brass cap stamped -  
 Pipe projects 18" above ground.

NBT - Cedar 6" S32°E 3.8 links scribed 1/16 BT S498  
 Cedar 9" N1°E 41 links scribed 1/16 BT T37N R11E

Pipe, OBT and NBT painted blue. SC-1/16 S | 23

CPI-1975

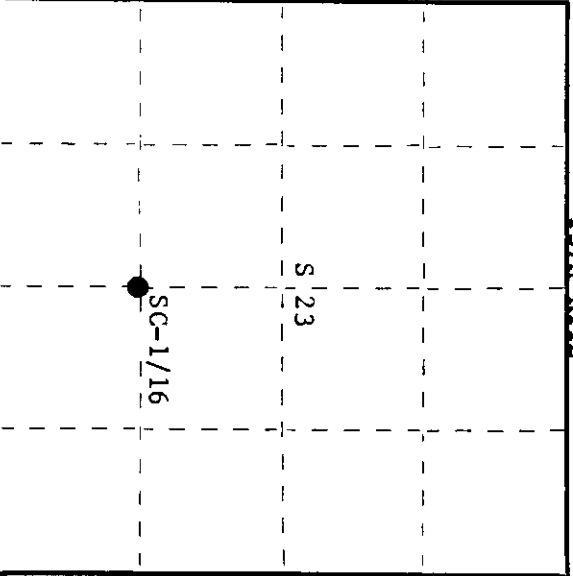

○ = Corner monument restored.

Dated at Rhinelander, Wis., this 9th day of December, 1975

Signature Philip T. Hansen Title Registered Land Surveyor Registration No. S-498  
 County Surveyor, Registered Land Surveyor, or other duly authorized official)

Office of Register of Deeds, County of Oneida  
 Instrument was filed in this office for record on the 4th day of December, 1975  
 at 1:00 o'clock P. M. I hereby certify that the within

Robert A. Kuehn  
 (Register of Deeds)

By: \_\_\_\_\_ Deputy

3711231020