


CERTIFIED LAND CORNER RESTORATION


P 21 Index No. P.21

State of Wisconsin } ss.  
 County of Oneida

I Phillip T. Hansen, do hereby certify that on the 24th day of June, 1975, I found evidence of the Quarter corner of Sections 23 and 24 Township 37 North, Range 11 East, Fourth Principal Meridian, as described hereon; and that from this evidence I established a new monument and accessories as described hereon to perpetuate the original location of this corner.

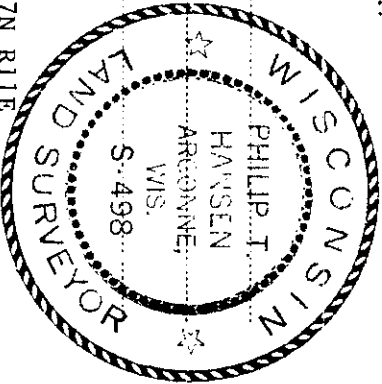

Resident witnesses:

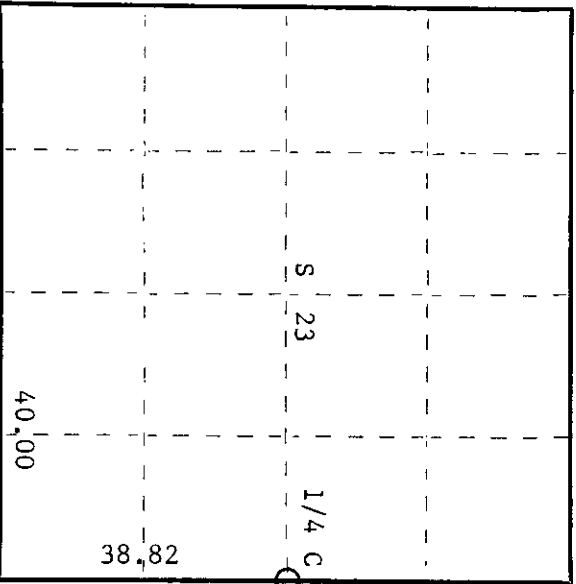

O = Corner monument restored.

CERTIFIED LAND CORNER RESTORATION

History of original corner establishment: Original corner established by Wm. E. Dougherty, Government Deputy Surveyor, in 1859 from which white birch 9" bears N85°W 10 links and hemlock 6" bears S75°E 17 links. Corner recovered by V.M. Maine, County Surveyor. Claims to have found original bearing trees - hemlock 6" S75°E was a dead stump, birch 9" N85°W 10 links also a stump. He set new squared post and NBT's - white pine 8" N77°E 62 links, hemlock stump N32°W 30 links, and a boulder 50", cross on it, S70°W 14 links. J.J. Melendy had recovered this corner in 1916. Original BT's still in evidence, marks plain. Marked new BT's - hemlock 10" S50°W 28 links, hemlock 9" N41°E 44 links, and hemlock 9" N32°W 37 links. Corner recovered by H.C. Lawrence, Reg. Land Surveyor, in 1948. Found post and BT's.

Description of corner evidence found:

Recovered 4" cedar post, squared and scribed 1/4 S S23; 1/4 S S24, in good condition. Also a 4" cedar post, squared and scribed 1/4 S, 1/4 S decayed and lying on the ground.

Recovered OBT - White pine 8" (15")	S77°E (S80°E)	62 links - scribed 1/4 S24 BT.
Hemlock 10"	N15°W	61 links)
Hemlock 12"	S26°E	90 links) - decayed stumps.
Maple 8"	N35°E	47 links)
Boulder 50"	S70°W	14 links - no cross visible.

Description of monument and accessories I established to perpetuate the original location of this corner.

Replaced 4" cedar post with 2-1/2" iron pipe with brass cap stamped -

Marked NBT - R. maple N32°W 29.4 links scribed 1/4 BT.

S498  
 T37N R11E  
 1/4 S23 | S24  
 CPI 1975

Dated at Rhinelander Wis., this 17th day of July, 1975.

Signature: *Phillip T. Hansen* Title: Registered Land Surveyor Registration No. S-498  
 County Surveyor, Registered Land Surveyor, or other duly authorized official

Office of Register of Deeds, County of Oneida  
 Instrument was filed in this office for record on the 1st day of October, 1975  
 at 3:00 o'clock P.M.

*Doris Verge Fuchs*  
 (Register of Deeds)

By: \_\_\_\_\_ Deputy

3711232080