

CERTIFIED LAND CORNER RESTORATION



State of Wisconsin }
 County of Oneida } ss.

I, Philip T. Hansen, do hereby certify that on the 2nd day of September 1975, I found evidence of the EC 1/16 corner of Sec. 23 Township 37 North Range 11 East, Fourth Principal Meridian, as described hereon; and that from this evidence I established a new monument and accessories as described hereon to perpetuate the original location of this corner:


Description of original monument and accessories and subsequent restorations: Corner established by H.C. Lawrence, Registered Land Surveyor, in 1948. No record of this corner having been previously established. From recovered $\frac{1}{4}$ corner between Section 22 and 23 he ran a random line east (Var. $1^{\circ} 55'$ E). At 39.50 Vaughans C $\frac{1}{4}$ corner was 94 lks south at right angles. At 79.15 intersect a point 1.92 chains north of $\frac{1}{4}$ corner. Set new EC 1/16 1.44 chs south of 59.32 $\frac{1}{2}$ east of W $\frac{1}{4}$, which is 19.82 $\frac{1}{2}$ chs intermediate between C $\frac{1}{4}$ and E $\frac{1}{4}$. Marked NBTs- Cedar 8" S 40 $^{\circ}$ W 21 lks, Hemlock 9" N 2 $^{\circ}$ W 23 $\frac{1}{2}$ lks, Dead cedar 10" N44 $^{\circ}$ E 17 $\frac{1}{2}$ lks.

Description of corner evidence found: Recovered Lawrence's 4" cedar post squared and scribed EC 1/16 S 23, EC 1/16 S 23 in poor condition.
 Recovered OBT Cedar 8" (9") S 40 $^{\circ}$ W 21 lks scribed EC 1/16 BT
 Hemlock 9" N 2 $^{\circ}$ W 23.5 lks scribed EC 1/16 BT
 Dead cedar 10" N 44 $^{\circ}$ E 17.5 lks scribed 1/16 BT

Description of monument and accessories I established to perpetuate the location of this corner:
 Extracted old paint from muck and replaced it with 1 $\frac{1}{2}$ "OD iron pipe with 2" brass cap stamped
 No additional accessories needed - BTs in good condition

S 498
 T 37 N R 11 E
 S/23
 EC 1/16
 CPI 1975

T 37 N R 11 E

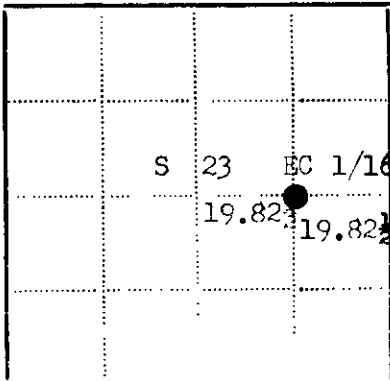

● - Corner monument restored
 □ -

Resident witnesses Glen Barker and Jim Claflin

Dated at Rhinelander Wisconsin, this 16th day of September 1975

Signature *Philip T. Hansen* Title Registered Land Surveyor
 (County Surveyor, Registered Land Surveyor, or other duly authorized official)

Surveyors Registration No. S 498

Office of Register of Deeds County of Oneida

I hereby certify that the within instrument was filed in this office for record on the 14th day of October 1975, and was filed in Book No. _____ Page No. _____ of County Records.

Signature *Doris Verage Kuehn* Title Register of Deeds

Township 37 North Range 11 East Section 23 Index No. _____ Page No. _____

P-20