


CERTIFIED LAND CORNER RESTORATION


U 18 Index No. 24-18

State of Wisconsin }
 County of Oneida } ss.

I Philip T. Hansen, do hereby certify that on the 20th day of June 1975, I found evidence of the SW-1/16 corner of Section 26 Township 37 North, Range 11 East, Fourth Principal Meridian, as described hereon; and that from this evidence I established a new monument and accessories as described hereon to perpetuate the original location of this corner.

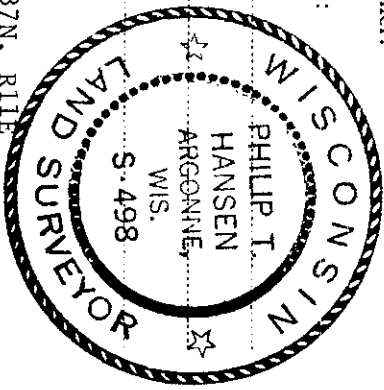

Resident witnesses:

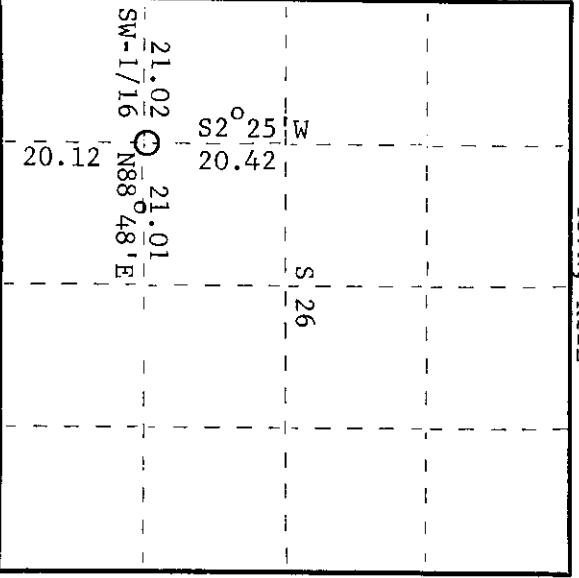

History of original corner establishment:
 Established by H.C. Lawrence, Registered Land Surveyor, during his retracement and subdivision survey during 1949. Ran N-S-1/4 line on needle set at 2°10'W var. from WC-1/16 to intersect South line 17 links East of W-1/16 post. Ran E-W-1/4 from S-1/16 between Sections 26 and 27, East on needle, vernier set at 1°20'E var., 42.03 chains to SC-1/16. Set 5" cedar post at 21.03 chains East of S-1/16 and 20.42 chains South of WC-1/16 bearing E-W line N88°48'E. Bearing N-S line S2°25'W. Marked spruce 9", N27°E, 29 links.

Description of corner evidence found:

Recovered 5" cedar post, squared and scribed SW-1/16 S26, SW-1/16 S26.

Recovered 0BT - B. spruce 9" (10") N27°E 29 links scribed SW-1/16 BT

Description of monument and accessories I established to perpetuate the original location of this corner.
 Replaced 5" cedar post with 1 1/2" iron pipe with 2" brass cap stamped - S498
 T37N, R11E

NBT - Hemlock 8" N68°W 41.7 links scribed 1/16 BT SW-1/16 S26
 CPI-1975

Dated at Rhinelander, Wis., this 16th day of July, 1975.

Signature: *Philip T. Hansen* Title: Registered Land Surveyor Registration No. S-498
 (County Surveyor, Registered Land Surveyor, or other duly authorized official)

Office of Register of Deeds, County of Oneida
 Instrument was filed in this office for record on the 1st day of October 1975 at 3:02 o'clock P.M.

Donna Lange Kuehn
 (Register of Deeds)

By: Deputy

371126 1030