

CERTIFIED LAND CORNER RESTORATION



Index No. **T-20**

T 20

State of Wisconsin } ss.
 County of Oneida

I Philip T. Hansen do hereby certify that on the 13th day of June, 1975, I found evidence of the EC-1/16 corner of Section 26 Township 37 North, Range 11 East, Fourth Principal Meridian, as described hereon; and that from this evidence I established a new monument and accessories as described hereon to perpetuate the original location of this corner.

Resident witnesses:

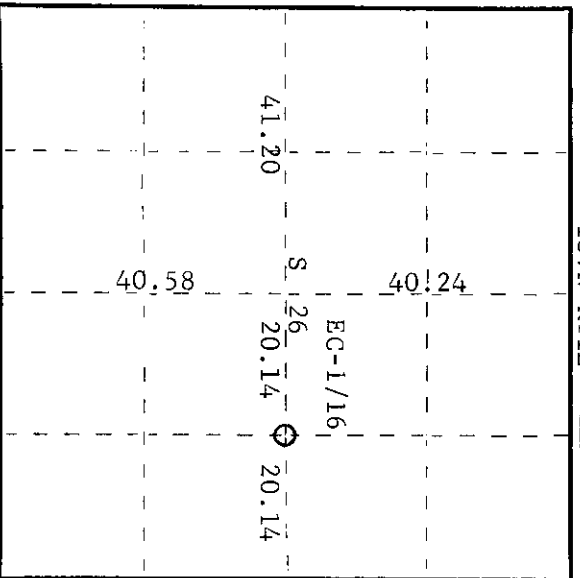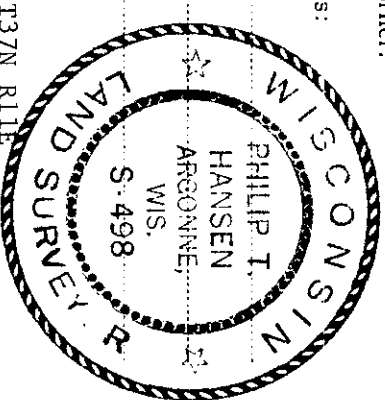

○ = Corner monument restored.

History of original corner establishment:

Corner established by H.C. Lawrence, Registered Land Surveyor, in 1949. He ran the E-W- $\frac{1}{2}$ line west (1°30' var.) to intersect the west line 19 links south of $\frac{1}{4}$ corner. Corrected bearing of line S88°38'W (mag.). He then ran the N-S- $\frac{1}{4}$ line south (1°00'W var.) to intersect south line 19 links west of $\frac{1}{4}$ corner. Set E-C-1/16 corner 5 links north of his random line 20.14 chains west of east quarter corner, from which hemlock 14" bears N35°W 8 links, and yellow birch 10" bears S55°W 28 links. Centerline of road is 90 links east of corner.

Description of corner evidence found:

Recovered 3" cedar post, squared and scribed EC-1/16 S26, EC-1/16 S26, in fair condition.
 Recovered OBT's - hemlock 14" N35°W 8 links - now a cut-off stump.
 Yellow birch 10" S55°W 28 links - now a cut-off stump.

Description of monument and accessories I established to perpetuate the original location of this corner.

Replaced 3" cedar post with 1 $\frac{1}{2}$ " O.D. iron pipe with 2" brass cap stamped - S498
 NBT's - sugar maple 8" S81°W 93.5 links, scribed 1/16 BT.
 Sugar maple 6" S45°E 65.3 links, scribed 1/16 BT.

T37N R11E
 S 26 EC-1/16
 CPT-1975

Dated at Rhineland, Wis., this 9th day of July, 1975.

Signature: *Philip T. Hansen* Title: Registered Land Surveyor Registration No. S-498
 (County Surveyor, Registered Land Surveyor, or other duly authorized official)

Office of Register of Deeds, County of Oneida, I do hereby certify that the within instrument was filed in this office for record on the 1st day of October, 1975 at 3:20 o'clock P.M.

Louis George Kuehn
 (Register of Deeds)

By: Deputy

3711262010