


CERTIFIED LAND CORNER RESTORATION

Index No. T-19  
7-19


State of Wisconsin } ss.  
County of Oneida

I Philip T. Hansen, do hereby certify that on the 13th day of June, 1975, I found evidence of the C-1/4 corner of Section 26 Township 37 North, Range 11 East, Fourth Principal Meridian, as described hereon; and that from this evidence I established a new monument and accessories as described hereon to perpetuate the original location of this corner.

Resident witnesses:

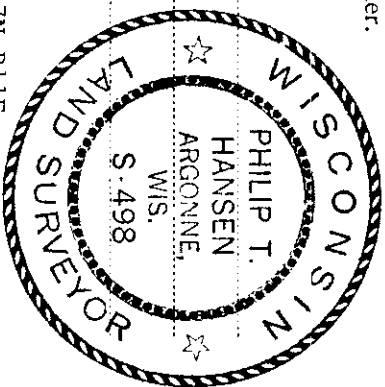

T37N R11E

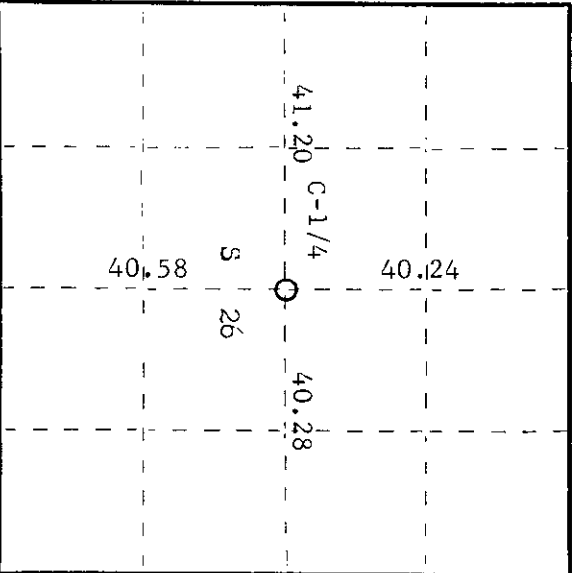

○ = Corner monument restored.

History of original corner establishment:

Corner established by H.C. Lawrence, Registered Land Surveyor, in 1947 during his retrace-ment and subdivision survey. He ran the E-W $\frac{1}{2}$  line west (1030' var.) 81.48 chains to intersect the west line, 19 links south of the  $\frac{1}{2}$  line. Corrected bearing S88 $^{\circ}$ 38'W. He then ran the N-S $\frac{1}{4}$  line south (1000' var.) From the N $\frac{1}{2}$  line to intersect the south line 19 links west of the  $\frac{1}{2}$  corner. Corrected line and set the C $\frac{1}{4}$  corner at 40.20 chains west of east  $\frac{1}{2}$  and 40.24 chains south of N $\frac{1}{2}$  corner. Set a 5" cedar post from which black ash 9" bears S150 $^{\circ}$ W 31 links, yellow birch 7" bears S410 $^{\circ}$ E 14 $\frac{1}{2}$  links, and cedar 7" bears N610 $^{\circ}$ E 24 $\frac{1}{2}$  links.

Description of corner evidence found:

Recovered 5" cedar post, squared and scribed C $\frac{1}{4}$  S26, C $\frac{1}{4}$  S26, in fair condition.  
Recovered OBT - black ash 9" (10") S150 $^{\circ}$ W 31 links, scribed C $\frac{1}{4}$  S26 BT  
Yellow birch 7" (8") S410 $^{\circ}$ W 14 $\frac{1}{2}$  links, scribed C $\frac{1}{4}$  S26 BT  
Cedar 7" (8") N610 $^{\circ}$ E (N640 $^{\circ}$ E) 24 $\frac{1}{2}$  links

Description of monument and accessories I established to perpetuate the original location of this corner.  
Replaced 5" cedar post with 2 $\frac{1}{2}$ " iron pipe with brass cap stamped -

No additional accessories.

T37N R11E  
C $\frac{1}{4}$  S 26  
CPI-1975

Dated at Rhineland, Wis., this 9th day of July, 1975

Signature Philip T. Hansen, Title Registered Land Surveyor Registration No. S-498  
(County Surveyor, Registered Land Surveyor, or other duly authorized official)

Office of Register of Deeds, County of Oneida at day of October, 1975  
Instrument was filed in this office for record on the 300 o'clock M. at day of October, 1975  
I hereby certify that the within

Doris Lenge Tuelke  
(Register of Deeds)

By Doris Lenge Tuelke Deputy