

CERTIFIED LAND CORNER RESTORATION

S 19 Index No. S-19



State of Wisconsin

County of Oneida

ss.

I, Philip T. Hansen, do hereby certify that on the 20th day of June, 1975, I found evidence of the NC-1/16 corner of Section 26 Township 37 North, Range 11 East, Fourth Principal Meridian, as described hereon; and that from this evidence I established a new monument and accessories as described hereon to perpetuate the original location of this corner.

Resident witnesses:

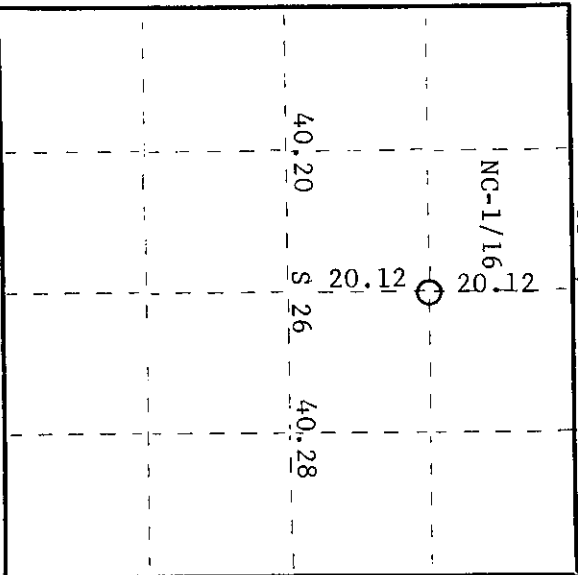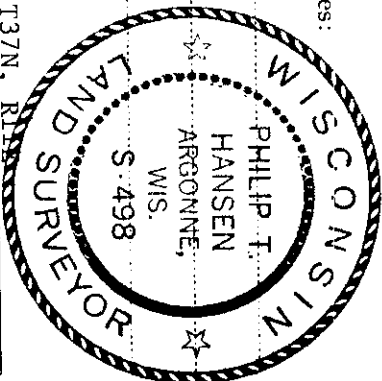

○ = Corner monument restored.

CERTIFIED LAND CORNER RESTORATION

S 19 Index No. S-19

History of original corner establishment:
Corner established by H.C. Lawrence, Registered Land Surveyor, during his retracement and subdivision survey in 1949. He set the NC-1/16 corner at 20.12 chains, equidistant between the N-1/4 and C-1/4 corner. Marked yellow birch 12", S30°W, 45 links.

Description of corner evidence found:

Recovered 4" cedar post, squared and scribed NC-1/16 S26, NC-1/16 S26, in poor condition.

Recovered OBT yellow birch 12", S30°W, 45 links, scribed NC-1/16 BT - now a 15' dead stub.

Description of monument and accessories I established to perpetuate the original location of this corner.

Replaced point of 4" cedar post with 1 1/2" OD iron pipe with brass cap stamped - S498

T37N, R11E

NBT's - White spruce 9" N34°E 27.4 links scribed 1/16 BT

White spruce 7" S84°E 28.5 links scribed 1/16 BT

NC-1/16 S 26

GPT-1975

Dated at Rhineland, Wis., this 16th day of July, 1975.

Signature: *Philip T. Hansen* Title: Registered Land Surveyor Registration No. S-498
County Surveyor, Registered Land Surveyor, or other duly authorized official

Office of Register of Deeds, County of Oneida
Instrument was filed in this office for record on the 1st day of October, 1975 at 3:00 o'clock P.M.

Donna Savage Tuelke
(Register of Deeds)

By: Deputy