

CERTIFIED LAND CORNER RESTORATION



Index No. **V-17**

State of Wisconsin

County of Oneida } ss.

I Philip F. Hansen, do hereby certify that on the 4th day of November, 1975, I found evidence of the E-1/16 corner of Sections 27 and 34 Township 37 North, Range 11 East, Fourth Principal Meridian, as described hereon, and that from this evidence I established a new monument and accessories as described hereon to perpetuate the original location of this corner.

Resident witnesses:
Glen Barker
Jim Claflin

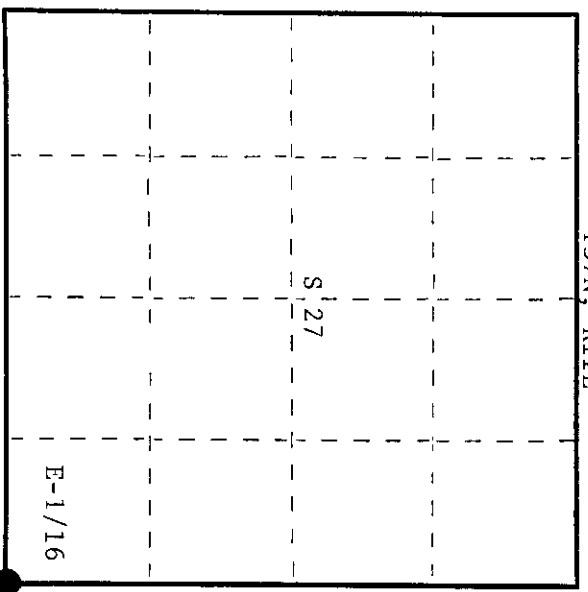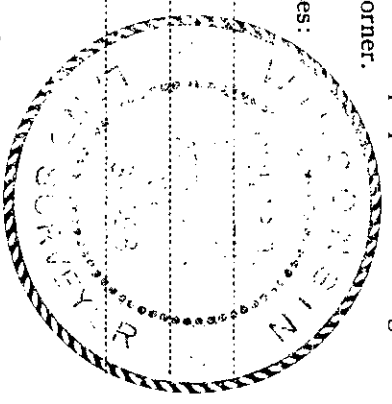

○ = Corner monument restored.

History of original corner establishment:
Original corner established by V.M. Maine, County Surveyor, in 1938.
Corner recovered by H.C. Lawrence, Registered Land Surveyor, in 1949. Found Maine's post intact 105 lks. north of his random line of 20.34 west of Section Corner 26, 27, 35, and 34.
Set 4" cedar post.

Description of corner evidence found:
Recovered 4" cedar post squared and scribed E-1/16 S27, E-1/16 S34, in fair condition.
Also found two old squared cedar stakes that bears N73°W, 7 lks.
Recovered OBT tamarack stump N42°E, 14 lks. (Possibly Maine's.)

Description of monument and accessories I established to perpetuate the original location of this corner.
Replaced H.C. Lawrence's cedar post with 1" iron pipe with 2" brass cap stamped -
Pipe projects 18" above ground.
Placed old posts beside iron pipe.
NBT's - Black spruce 4" S50°E 33 lks. Scribed 1/16 BT. T37N, R11E
Black spruce 5" N38°W 46.8 lks. Scribed 1/16 BT.
Pipe and NBT's painted blue.
S 27
E-1/16
S 134
CPI-1975

Dated at Rhineland, Wis., this 11th day of November, 1975

Signature *Philip F. Hansen* Title Registered Land Surveyor Registration No. S-498
(County Surveyor, Registered Land Surveyor, or other duly authorized official)

Office of Register of Deeds, County of Oneida
Instrument was filed in this office for record on the 11th day of November, 1975
at 10:00 o'clock P.M.

Debra Verage Fuchs
(Register of Deeds)

By: Deputy

3711270000