

CERTIFIED LAND CORNER RESTORATION


Index No. **V-14**

State of Wisconsin

County of Oneida } ss.

I, Phillip T. Hansen, do hereby certify that on the 5th day of November, 1975, I found evidence of the W-1/16 corner of Sections 27 and 34 Township 37, North, Range 11 East, Fourth Principal Meridian, as described hereon; and that from this evidence I established a new monument and accessories as described hereon to perpetuate the original location of this corner.

Resident witnesses:  
Glen Barker  
Jim Claflin

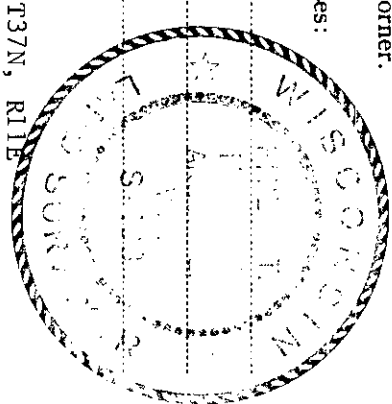


History of original corner establishment:  
 Corner established by V.M. Maine, County Surveyor, in 1938. Set corner at 20.28 1/2 chains west of south 1/4 corner equidistant. Set cedar post from which aspen 5" bears N32°W, 6-1/2 lks.; aspen 5" bears S73-1/2E, 26 lks.; and balsam 7" bears S35°W, 49 lks. Corner recovered by H.C. Lawrence, Registered Land Surveyor, in 1949. Found Maine's post and BT's in good condition.

Description of corner evidence found:  
 Recovered Maine's 4" cedar post, squared and scribed 1/8 S27, 1/8 S34, in poor condition.  
 Recovered OBT's - Aspen 5" N32°W 6.5 lks. Now decayed stump.  
 Aspen 5" S73-1/2°E 26 lks. Now decayed stump.  
 Balsam S35°W 49 lks. Now decayed stump.

Description of monument and accessories I established to perpetuate the original location of this corner.  
 Replaced 4" cedar post with 1" O.D. iron pipe with brass cap stamped - S498  
 Pipe projects 18" above ground. T37N, R11E  
 NBT's - Maple 12" S17°E 102 lks. Scribed 1/16 BT.  
 No other suitable trees for BT's.

S | 27  
 W-1/16 +  
 S | 34

CPI-1975

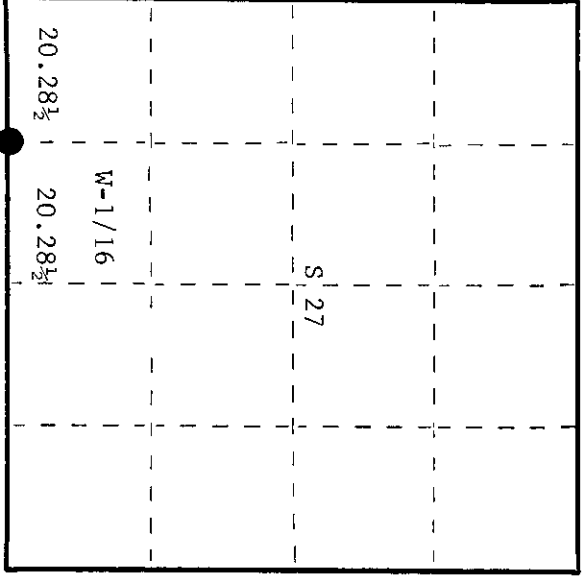

○ = Corner monument restored.

Dated at Rhineland, Wis., this 11th day of November, 1975

Signature Phillip T. Hansen, Title Registered Land Surveyor Registration No. S-498  
 (County Surveyor, Registered Land Surveyor, or other duly authorized official)

Office of Register of Deeds, County of Oneida  
 at 10 o'clock A.M. 11th day of November, 1975  
 I hereby certify that the within instrument was filed in this office for record on the 11th day of November, 1975.

Donna Verage Kuehn  
 (Register of Deeds)

By Donna Verage Kuehn Deputy

3711270030