

CERTIFIED LAND CORNER RESTORATION



U 17 Index No. U-17

State of Wisconsin

County of Oneida } ss.

I Philip T. Hansen, do hereby certify that on the 20th day of June 1975, I found evidence of the S-1/16 corner of Sections 26 and 27 Township 37 North, Range 11 East, Fourth Principal Meridian, as described hereon; and that from this evidence I established a new monument and accessories as described hereon to perpetuate the original location of this corner.

Resident witnesses:

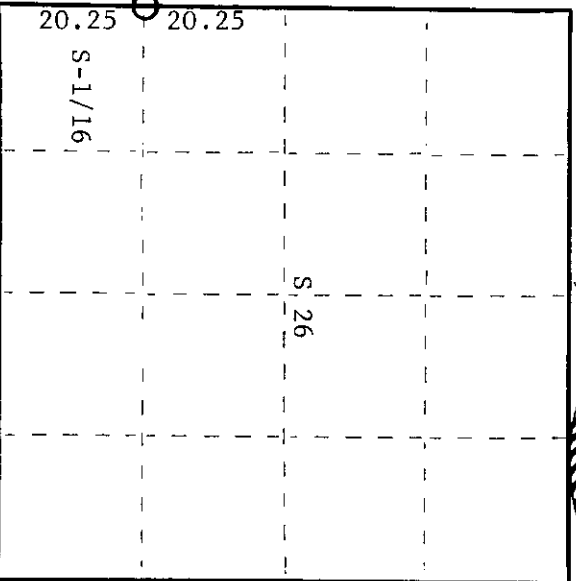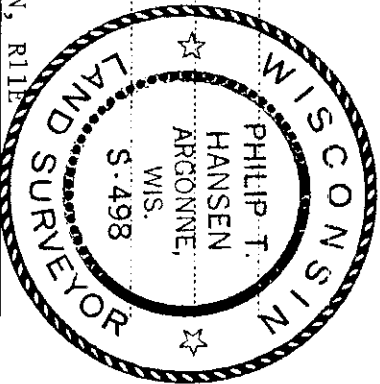

○ = Corner monument restored.

History of original corner establishment:
Original corner set by J.J. Melendy, Surveyor for Gagen Lumber Company. Re-establish corner 4" cedar post. Corner recovered by V.M. Maine, County Surveyor, from which balsam 9" bears S51°W, 107½ links. Old pine stump bears N43°W, 53½ links.

Corner recovered by H.C. Lawrence, Registered Land Surveyor. Maine's post is 20.25 chains North of SW corner. Recovered Maine's BT balsam 9", S51°W, 107½ chains. Also, old pine stump, N43°E, 107½ links. Set 4" cedar post from which NBT aspen 12" bears S84°W, 62 links.

Description of corner evidence found:
Recovered H.C. Lawrence's 4" cedar post, squared and scribed S-1/16 S26, S-1/16 S27, in fair condition.

Recovered - Lawrence's 12" aspen S84°W 62.0 links
Maine's balsam 9" S57°W 107.5 links
No trace of old pine stump.

Description of monument and accessories I established to perpetuate the original location of this corner.
Replaced 4" cedar post with 1½" OD iron pipe with 2" brass cap stamped -

NBT - White spruce 9"	N29°W	27.3 links	scribed 1/16 BT	S-1/16	S27	S26
White spruce 10"	N72°W	92.0 links	scribed 1/16 BT	S-1/16	S27	S26

T37N, R11E
S498
CPI-1975

Dated at Rhinelander, Wis., this 23rd day of June, 1975.

Signature: *Philip T. Hansen* Title: Registered Land Surveyor Registration No. S-498
County Surveyor, Registered Land Surveyor, or other duly authorized official

Office of Register of Deeds, County of Oneida
Instrument was filed in this office for record on the 1st day of October 1975 at 3:00 o'clock P.M.

Terrie Lange Kuehn
(Register of Deeds)

By: Deputy

3711271000