

CERTIFIED LAND CORNER RESTORATION

Index No. **J-16**

State of Wisconsin

County of Oneida } ss.

I Philipp T. Hansen

certify that on the 3rd day of October, 1975, I found evidence of the SE-1/16 Section 27

corner of Township 37


North, Range 11 East, Fourth Principal Meridian,

as described hereon; and that from this evidence I established a new monument and accessories as described hereon to perpetuate the original location of this corner.


Resident witnesses:

Glen Barker

Jim Clafin

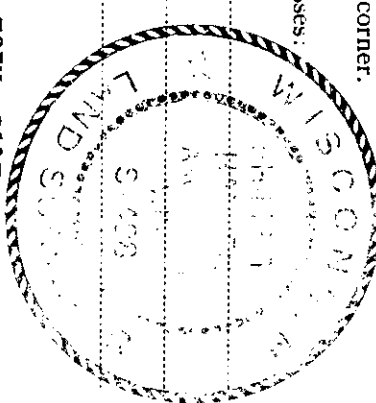

T37N, R11E

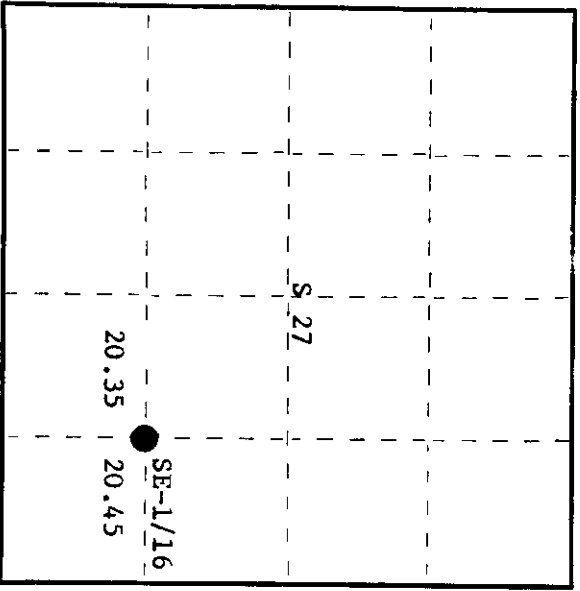

○ = Corner monument restored.

History of original corner establishment:

Original corner established by H.C. Lawrence, Registered Land Surveyor, in 1949. He ran a random line west (Var. 1015'±) 40.80 chains to a point on corrected N-S 1/4 line, 1.46 chains south of SC-1/16. Corrected line N89°12'W. He then ran random line south (Var. 3040'W) from EC-1/16, 40.29 chains to point 10 links west of E-1/16 corner. Corrected corner SE-1/16 falls in Consolidated Road. Set a witness post 31 links east of true position. B.O. boulder N47°0'W, 72-1/2 links and boulder S20°W, 37-1/2 links from true corner.

Description of corner evidence found:

Recovered witness corner E31 links, scribed SE-1/16 S27 WC, E 31 links.
Recovered boulder N47°W, 72.5 links and boulder S20°W, 37.5 links.

Description of monument and accessories I established to perpetuate the original location of this corner. Re-established corner from bearings and distance from W.C. and boulders. Set a 1-1/2" x 18" iron pipe at true corner, driven in flush with ground.

Set a 1-1/2" OD iron pipe with 2" brass cap for witness corner at 70 links south of true corner. Cap stamped -

| | | | | |
|----------------------|-------|------------|-----------------|-------------------|
| NBT's - B. spruce 6" | S41°W | 57 links | Scribed 1/16 BT | T37N R11E |
| B. spruce 6" | S6°E | 53.4 links | Scribed 1/16 BT | S498 |
| | | | | SE-1/16 S 27 W.C. |
| | | | | N 70 links |
| | | | | CPI-1975 |

Witness post and BT's painted blue. Old and new BT's measurement and bearing are to true corner.

Dated at Rhinelander Wis., this 10th day of November, 1975

Signature *Philipp T. Hansen* Title Registered Land Surveyor Registration No. S-498
(County Surveyor, Registered Land Surveyor, or other duly authorized official)

Office of Register of Deeds, County of Oneida
Instrument was filed in this office for record on the 9th day of November, 1976 at 1:35 o'clock P.M.

Dorcas Virginia Kuehn
(Register of Deeds)

By: Deputy

3711271010