

CERTIFIED LAND CORNER RESTORATION

Index No. **T-16**

State of Wisconsin


County of Oneida } ss.

I Philip T. Hansen, do hereby certify that on the 4th day of November, 1975, I found evidence of the EC-1/16 corner of Section 27


Township 37, North, Range 11 East, Fourth Principal Meridian,

as described hereon; and that from this evidence I established a new monument and accessories as described hereon to perpetuate the original location of this corner.

Resident witnesses:
Glen Barker
Jim Claflin

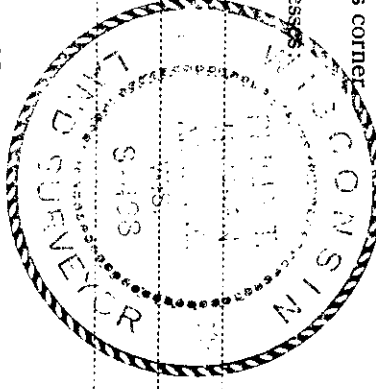

T37N, R11E

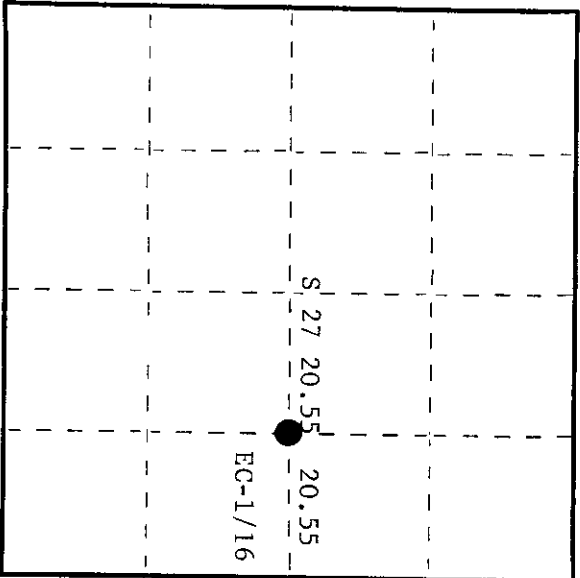

○ = Corner monument restored.

History of original corner establishment:

Corner established by H.C. Lawrence, Registered Land Surveyor, in 1949. He ran the N-S and E-W 1/4 lines from recovered 1/4 corners to establish C-1/4 corner. Set the E-C-1/16 corner at 20.55 chains, equidistant between C-1/4 and E-1/4 corner. Sets in grassy wet tag alder and tamarack swamp. Marked NBT's - Tamarack stub 6" x 8' high, N27°W, 47 lks. Tamarack stump 12", N72°E, 25-1/2 lks.

Description of corner evidence found:

Recovered 4" tamarack post, squared and scribed EC-1/16, S27, EC-1/16 in poor condition. Recovered OBT's - Tamarack stub 8', N27°W, 47 lks., scribed BT. Now down. Tamarack stump 12", N72°E, 25.5 lks., scribed EC-1/16, S27 BT.

Description of monument and accessories I established to perpetuate the original location of this corner.
Replaced 4" tamarack post, with 1-1/2" O.D. iron pipe with brass cap stamped - S498
Pipe projects 24" above ground.
NBT - Black spruce 6" S82°W 87.7 lks. Scribed 1/16 BT. T37N, R11E
No other trees suitable for BT's.
Pipe and BT's painted blue.

S 27
EC-1/16

GPI-1975

Dated at Rhineland, Wis. this 11th day of November, 1975.

Signature Philip T. Hansen Title Registered Land Surveyor Registration No. S-498
(County Surveyor, Registered Land Surveyor, or other duly authorized official)

Office of Register of Deeds, County of Oneida hereby certify that the within instrument was filed in this office for record on the 11th day of November, 1975 at 10:00 o'clock A. M.

Donna Verge Kuehn
(Register of Deeds)

By: _____ Deputy

3711272010