

CERTIFIED LAND CORNER RESTORATION

Index No. **T-14**

State of Wisconsin


County of Oneida } ss.

I Philip T. Hansen, do hereby certify that on the 5th day of November, 1975, I found evidence of the WC-1/16 Section 27 corner of Township 37 North, Range 11 East, Fourth Principal Meridian,

as described hereon; and that from this evidence I established a new monument and accessories as described hereon to perpetuate the original location of this corner.

Resident witnesses:

Glen Barker
Jim Clafflin

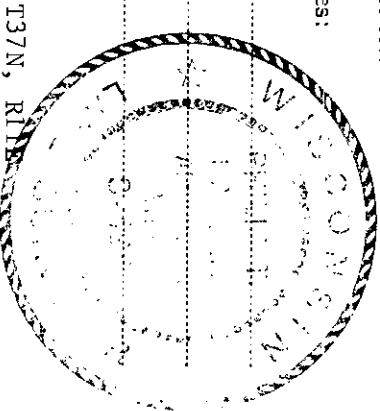


History of original corner establishment:
Corner established by H.C. Lawrence, Registered Land Surveyor, in 1949. He ran the N-S and E-W 1/4 lines from re-established 1/4 corner and corrected same to establish C-1/4 corner. Set 4" cedar post for WC-1/16 at 20.60 chains N88° 14'W from C-1/4 equidistant from which W. birch 7" bears N50°E, 29 lks.

Description of corner evidence found:
Recovered 4" cedar post, squared and scribed S27 WC-1/16, S27 WC-1/16 in poor condition.
Recovered 0BT - W. birch 7" (12") N50°E (N56°E) 29 lks. Scribed WC-1/16 BT.

Description of monument and accessories I established to perpetuate the original location of this corner.
Replaced 4" cedar post with 1-1/2" O.D. iron pipe with 2" brass cap stamped -
Pipe projects 18" above ground. Reset wood post beside it. S498
NBT's - W. Birch 7" N15°W 44 lks. Scribed 1/16 BT. T37N, R11E
W. Birch 7" S44°W 19.7 lks. Scribed 1/16 BT.
Pipe and BT's painted blue.

WC-1/16 S 27

CPI-1975

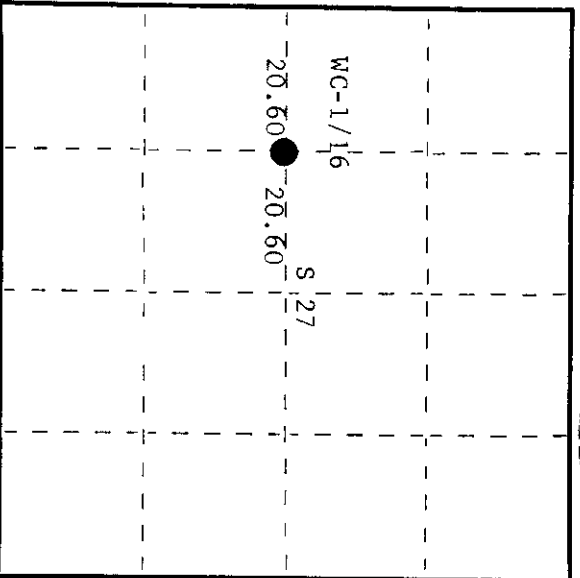

○ = Corner monument restored.

Dated at Rhinelander, Wis, this 11th day of November, 1975.
Signature: *Philip T. Hansen* Title: Registered Land Surveyor Registration No. S-498
(County Surveyor, Registered Land Surveyor, or other duly authorized official)

Office of Register of Deeds, County of Oneida
Instrument was filed in this office for record on the 11th day of November, 1976 at 10:00 o'clock A.M.

Lore Verage Kuehn
(Register of Deeds)

By: _____ Deputy