

CERTIFIED LAND CORNER RESTORATION

Index No. **S-15**

State of Wisconsin

County of Oneida } ss.

History of original corner establishment: Corner established by H.C. Lawrence, Registered Land Surveyor, in 1949. Set NC-1/16 at 19.45 chains South of N-1/4, equidistant between it and the re-established C-1/4.

Marked - aspen 7" N63°W 9 links
 aspen 8" N68°E 8 links


I, Phillip T. Hansen, do hereby certify that on the 4th day of December, 1975, I found evidence of the NC-1/16 corner of Section 27 Township 37, North, Range 11 East, Fourth Principal Meridian.

as described hereon; and that from this evidence I established a new monument and accessories as described hereon to perpetuate the original location of this corner.

Resident witnesses:

Glen Barker

Jim Claflin

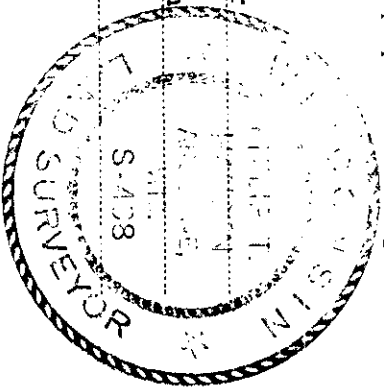

Description of monument and accessories I established to perpetuate the original location of this corner.
 Replaced Lawrence's 4" cedar post with 1 1/2" O.D. iron pipe with brass cap stamped -
 Pipe projects 18" above ground.

NBT - White spruce 6"	S44°E	40.4 links	scribed 1/16 BT	S498
White spruce 6"	N17°W	73.2 links	scribed 1/16 BT	T37N R11E
				NC-1/16
				S 27

Pipe, OBT, and NBT painted blue.

CPI-1975


Dated at Rhineland, Wis., this 10th day of December, 1975.

Signature Phillip T. Hansen Title Registered Land Surveyor Registration No. S-498
 (County Surveyor, Registered Land Surveyor, or other duly authorized official)

Office of Register of Deeds, County of Oneida, I hereby certify that the within instrument was filed in this office for record on the 4th day of December, 1975 at 1:20 o'clock P. M.

Phillip T. Hansen
 (Register of Deeds)

By: _____ Deputy

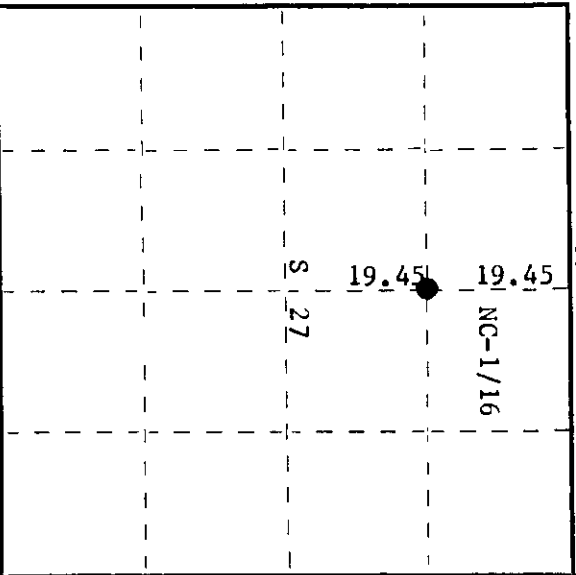

○ = Corner monument restored.

3711273020