

CERTIFIED LAND CORNER RESTORATION

Index No. **7-13**



State of Wisconsin } ss.  
 County of Oneida

I Phillip T. Hansen, do hereby certify that on the 3rd day of December, 1975, I found evidence of the Quarter corner of Section 27 and 28 Township 37, North, Range 11 East, Fourth Principal Meridian, as described hereon; and that from this evidence I established a new monument and accessories as described hereon to perpetuate the original location of this corner.

Resident witnesses:

Glen Barker

Jim Clafflin

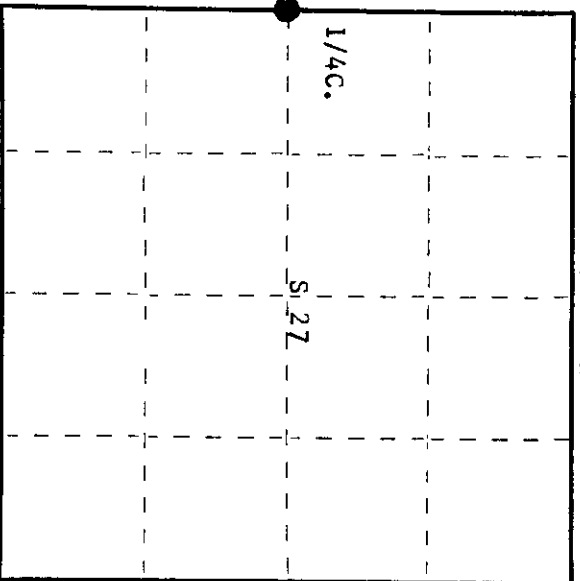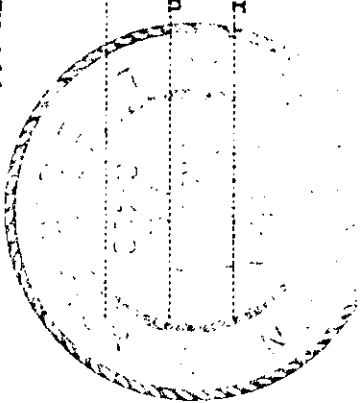

○ = Corner monument restored.

History of original corner establishment: Original corner established by William E. Dougherty, Deputy Surveyor, in 1859 from which Aspen 12" bears S80°E, 12 links and fir 9" bears N85°W, 25 links. Corner re-established by V.M. Maine, County Surveyor, using proportional measurement. Set a 2-1/2" iron pipe marked birch 12", S40°50'W, 22 1/2 links; aspen 14" S86°E, 11 1/2 links; and W. pine 20", S9°E, 106 1/2 links.

Corner recovered by H.C. Lawrence, Registered Land Surveyor, in 1949. Ran the line North from section corner 27, 28, 34-35. At 39.80 1/2 found Maine's 1/4 corner 23 1/2 links East.

Description of corner evidence found: Recovered 2 1/2" iron pipe with brass cap set by V.M. Maine stamped - Pipe projects 24" above ground. Also recovered H.C. Lawrence's 5" cedar post squared and scribed 1/4 S27, 1/4 S28 beside the iron pipe. Also found an old squared cedar post lying under brush scribed 1/4 S27. T37N R11E

Recovered OBT's - Birch 12" S41°W 22.5 links Now a decayed stump. 28 1/4 27  
 Aspen 14" S86°15'E 11.5 links Blown down and dead. 4  
 W. pine 20" S9°E 106.5 links Now a cut-off stump. 7 1/2 M  
 Scribed 1/4 S BT.

Description of monument and accessories I established to perpetuate the original location of this corner. As the iron pipe was in perfect condition we left as is. Also left H.C. Lawrence's wood post beside it.

Painted iron pipe, wood post, and BT's blue.

NBT's - Maple 9" N78°W 35 links scribed 1/4 BT  
 Maple 5" N4°W 31.3 links scribed 1/4 BT

Dated at Rhineland, Wis., this 10th day of December, 1975.

Signature Phillip T. Hansen Title Registered Land Surveyor Registration No. S-498  
 (County Surveyor, Registered Land Surveyor, or other duly authorized official)

Office of Register of Deeds, County of Oneida, I hereby certify that the within instrument was filed in this office for record on the 4th day of January, 1976 at 10 o'clock A. M.

James A. ...  
 (Register of Deeds)

By James A. ... Deputy

3711282000